


T.28S.,R.12W.,W.M.

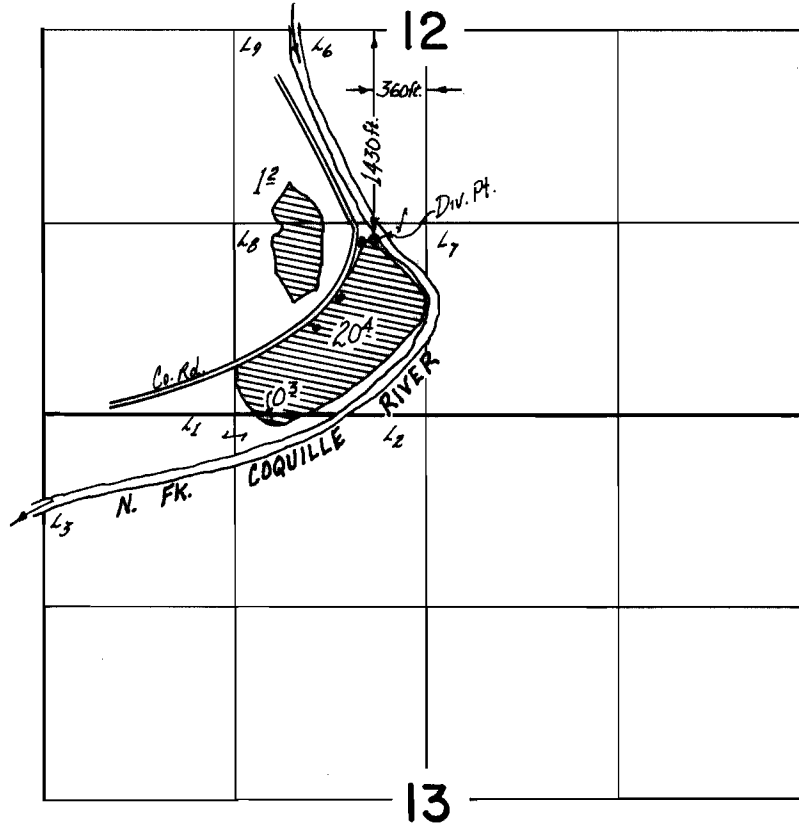

**FINAL PROOF SURVEY**  
UNDER

Application No. 39692 Permit No. 29483  
IN NAME OF

CHARLES VINCENT

Surveyed 15 JULY 1972, by L. E. GOULD