


T.28S.R.12W.W.M.

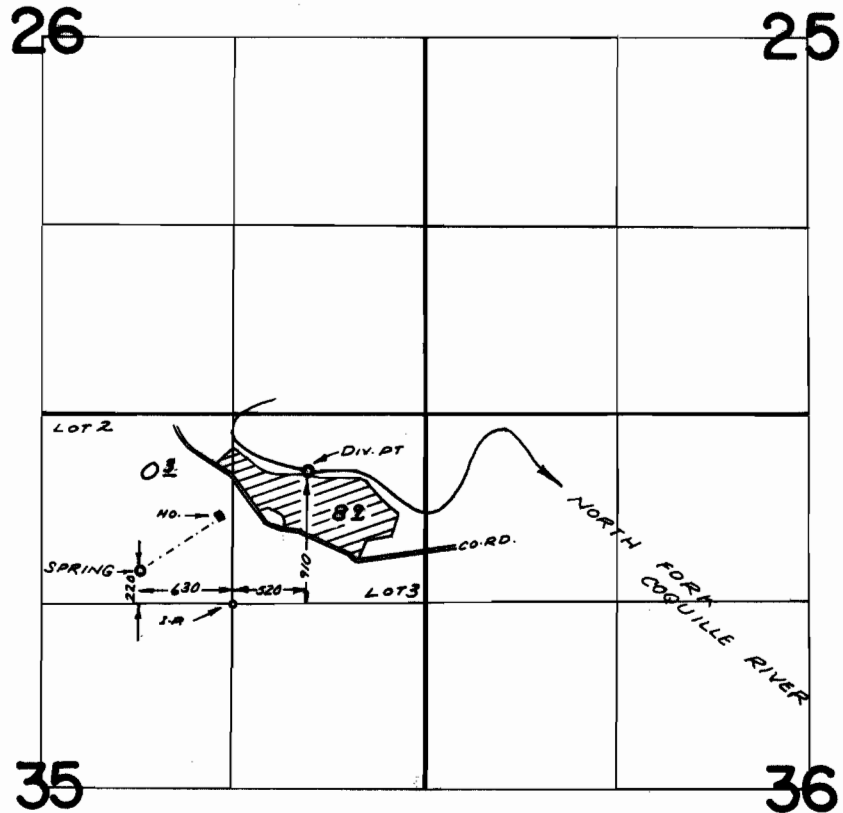

FINAL PROOF SURVEY
UNDER

Application No. 39603 Permit No. 29517
IN NAME OF

CHARLES O. & DOROTHY B. NEWTON

Surveyed JULY 18 1972, by R. MUCKEN