


T.28S., R.14 & 15W., W.M.

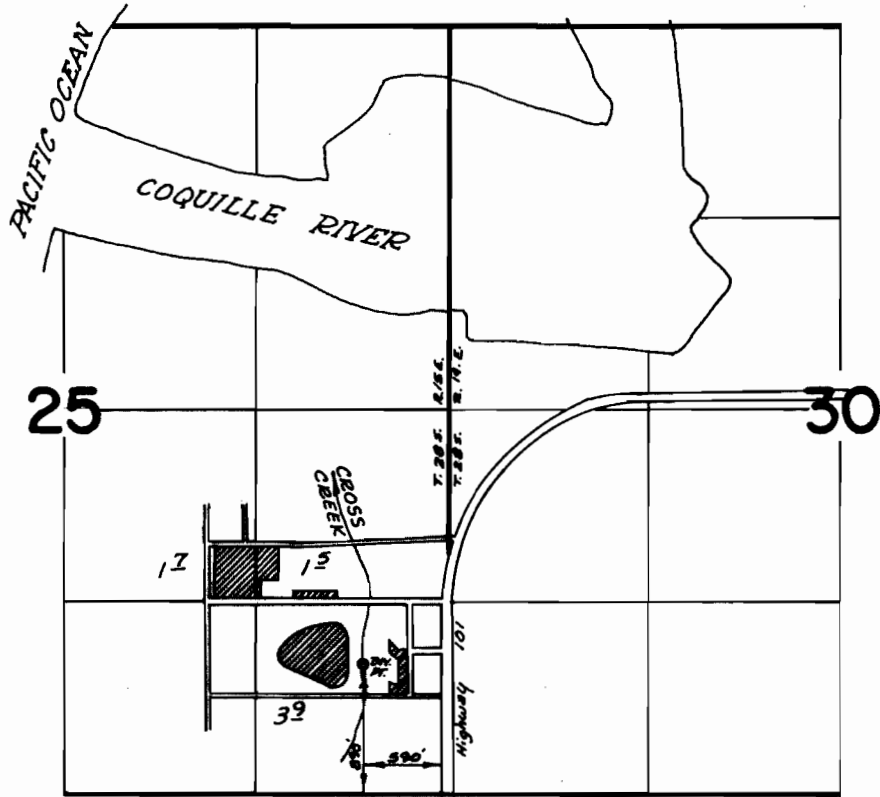

FINAL PROOF SURVEY
UNDER

Application No. 40214 Permit No. 29994
IN NAME OF

SCHOOL DISTRICT 54

Surveyed July 19 1972, by L.E. Gould