


Township 39 South,

Range 1 E W. M.

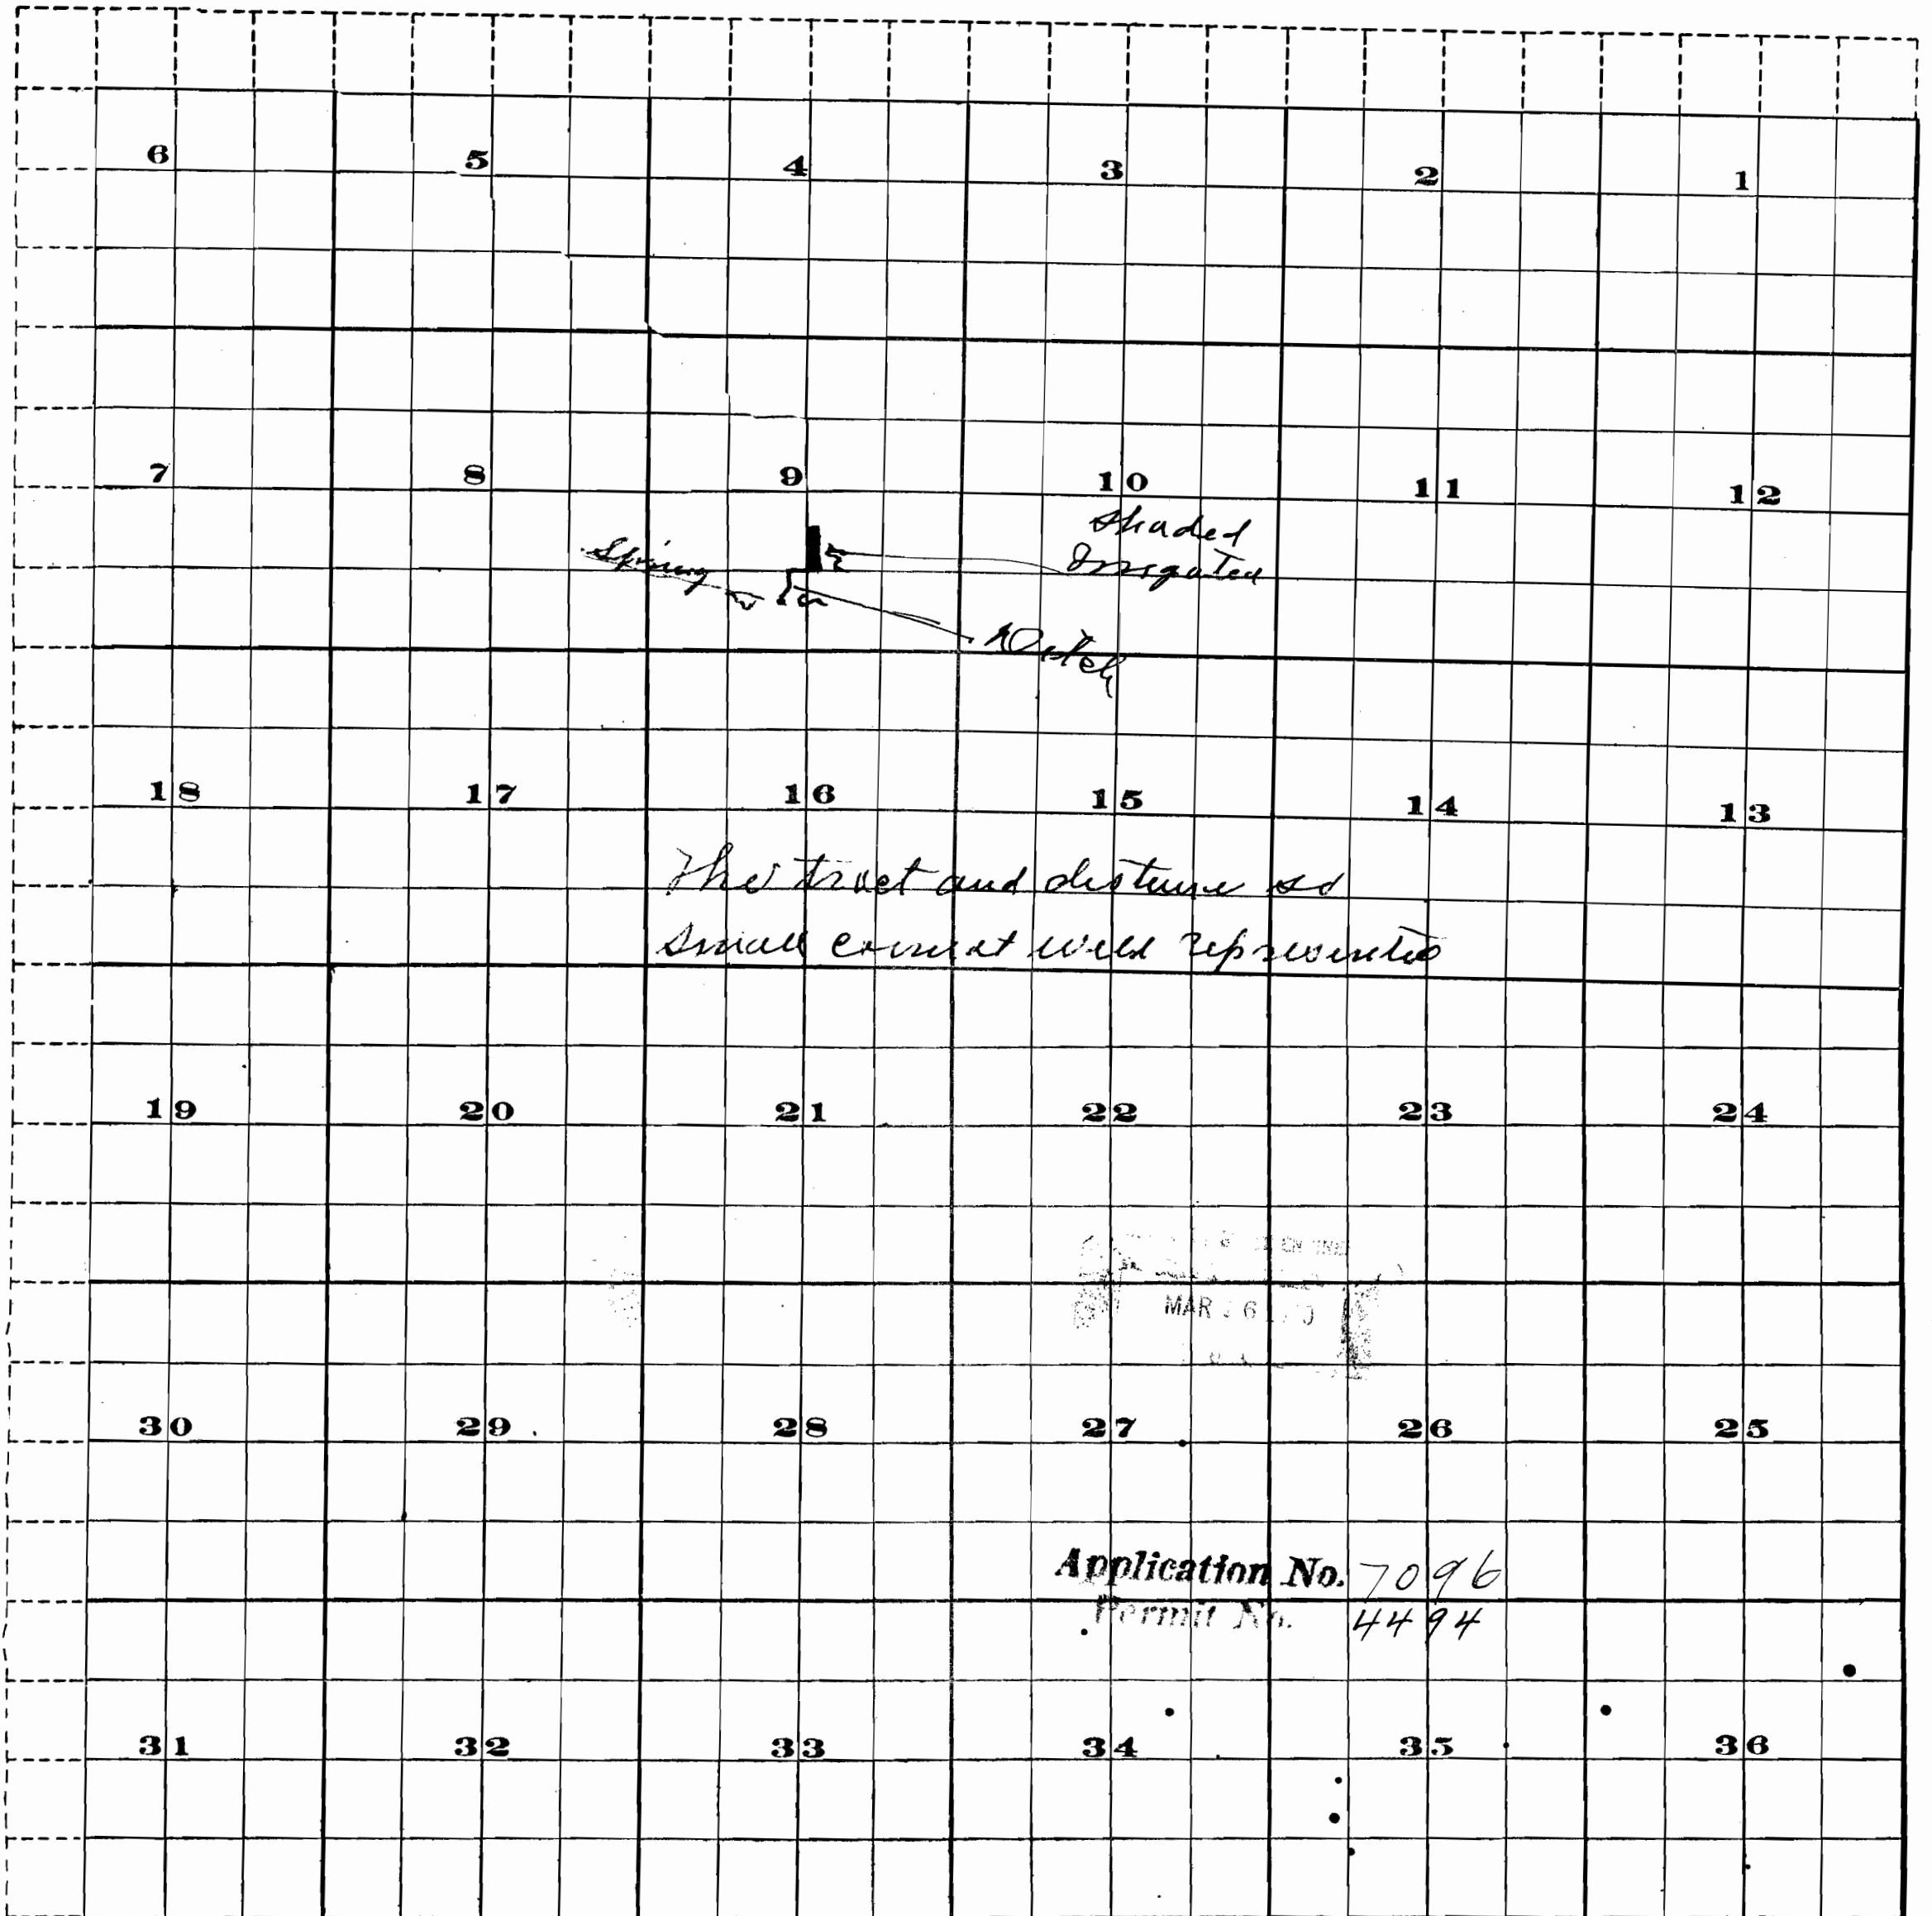

Scale 2 in
to the mile

6967

6967

6967