


T.28S., R.13 & 14 W., W.M.

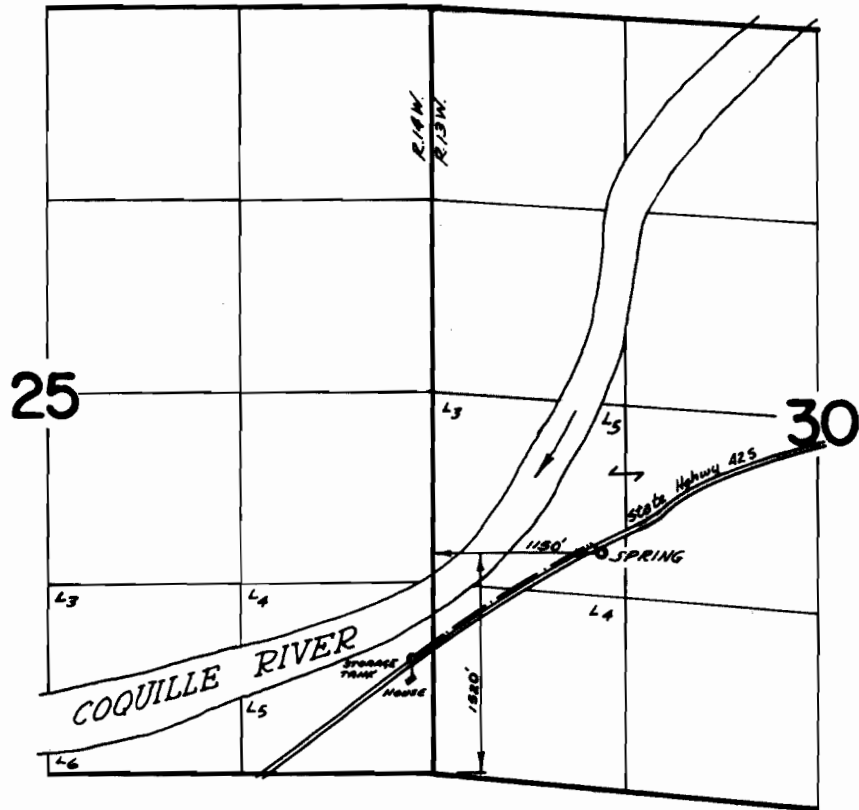

FINAL PROOF SURVEY
UNDER

Application No. 40280 Permit No. 30027
IN NAME OF

LEONARD GIBBS

Surveyed July 20 1972, by L. E. Gould