


# T. 30S. R. 15W. W.M.

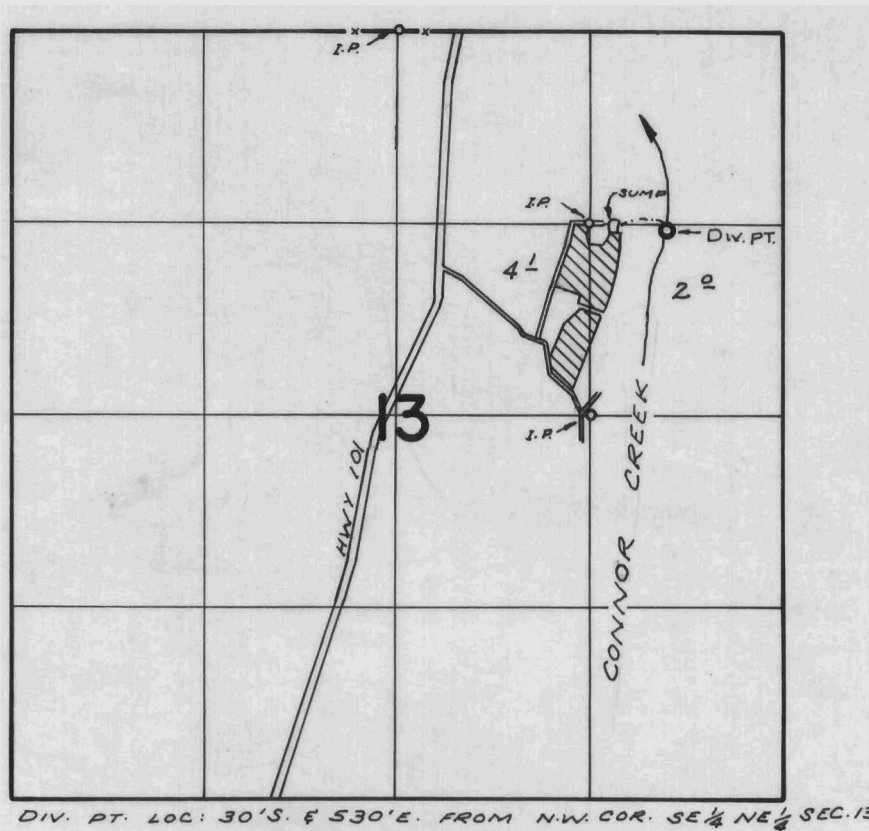

## FINAL PROOF SURVEY UNDER

Application No. 40903 Permit No. 30531  
IN NAME OF

.....DONALD O. FRASER.....

Surveyed AUG. 10, 1972, by R. MUCKEN