


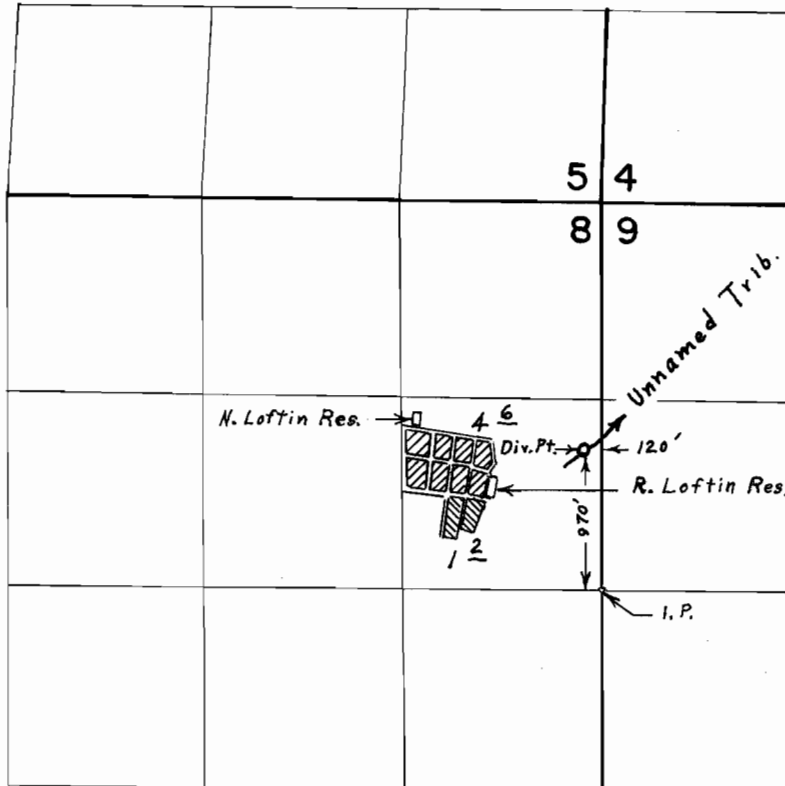

T. 29 S.R. 14 W.W.M.



Norvill L. Loftin 
 Robert M. Loftin 

FINAL PROOF SURVEY UNDER

Application No. 40981 Permit No. 30559
 IN NAME OF

NORVILL L. & ROBERT M. LOFTIN

Surveyed April 18, 1972, by L. E. Gould