


T. 28 S., R. 13 & 14 W., W.M.

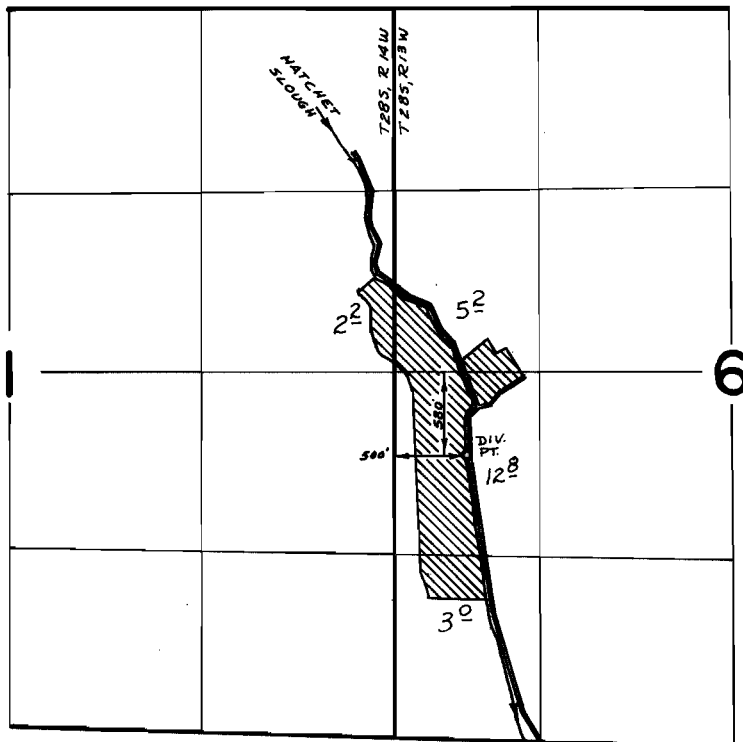

FINAL PROOF SURVEY
UNDER

Application No. 41655 Permit No. 30880
IN NAME OF

JOE C. STEWART

Surveyed July 20 1972, by L. E. Gould