


# T.28S., R.13&14W., W.M.

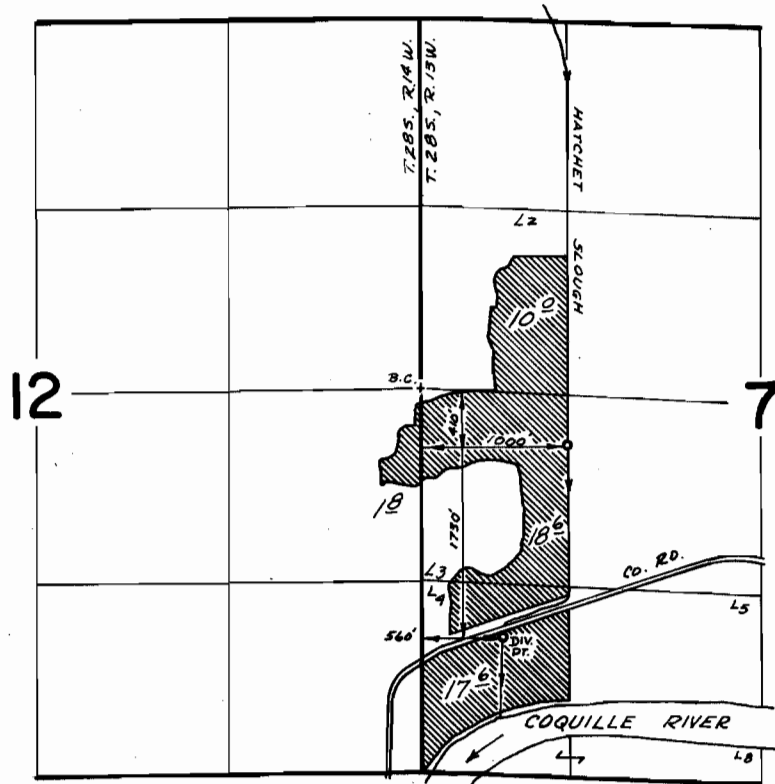

## FINAL PROOF SURVEY UNDER

Application No. 41695 Permit No. 31111  
IN NAME OF

TOM McCULLOCH

Surveyed July 19 1972, by L.E. Gould