


T.28&29S.R.14&15W.W.M.

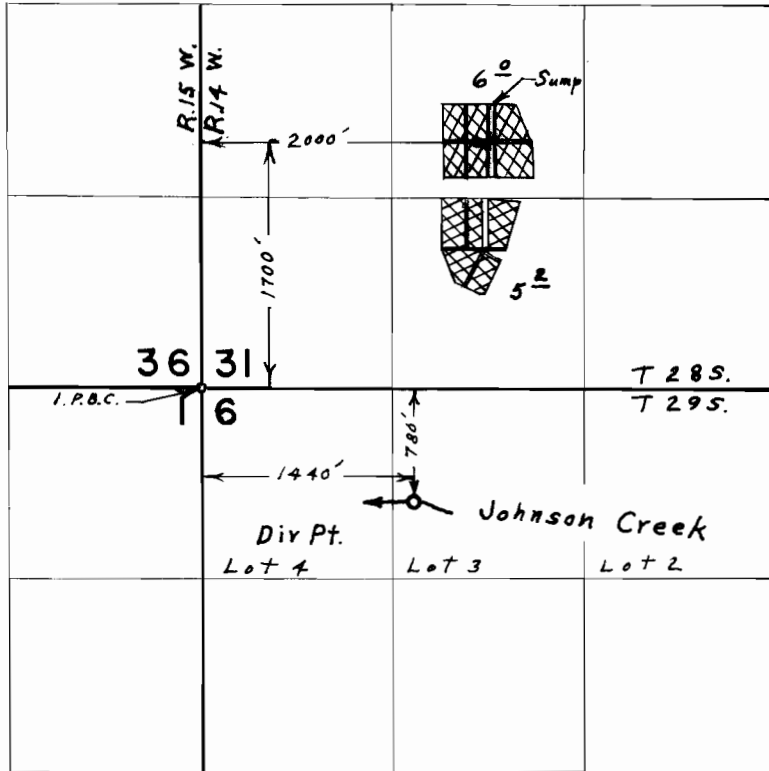

- Cranberry Harvest
- Frost Control (Johnson Cr.)
- Frost Control (Sump)

FINAL PROOF SURVEY UNDER

G-3381 G-3234
 Application No. 41878 Permit No. 31332
 IN NAME OF

JACK DEAN

Surveyed April 12, 1972, by L. E. Gould