


T.28S.R.12W.W.M.

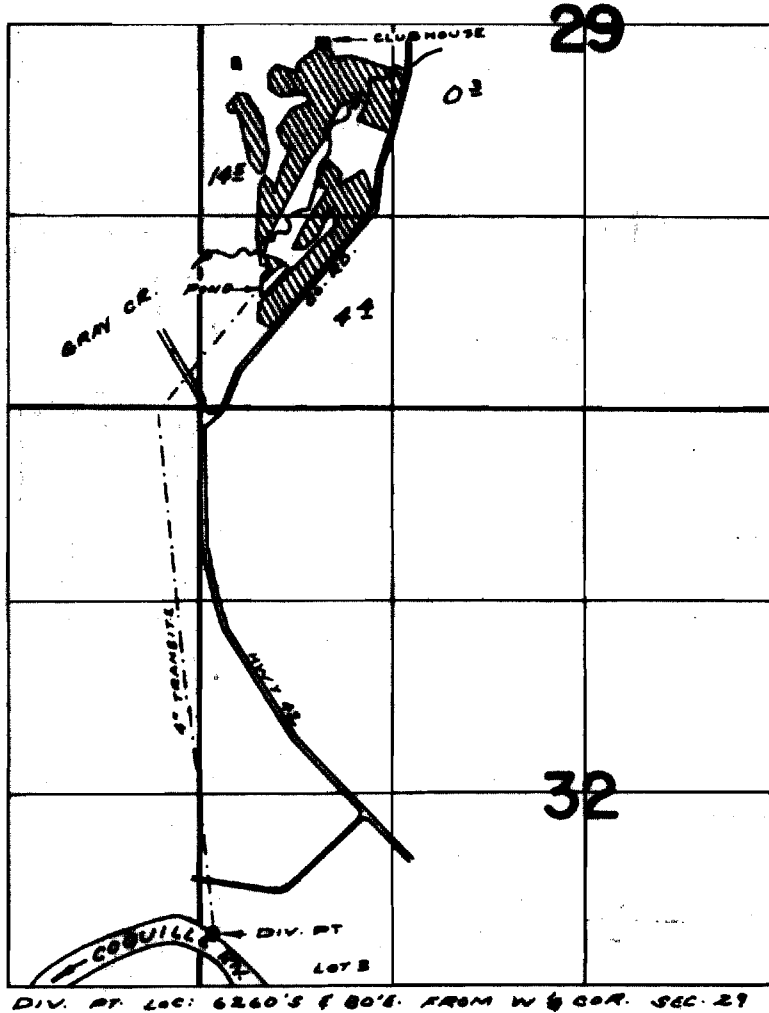

FINAL PROOF SURVEY UNDER

Application No. 42/05 Permit No. 3/534
IN NAME OF

CORVILLE VALLEY LODGE No. 1935, B. P. O. E.

Surveyed JULY 20, 1922, by R. MUCKEN