


T.27S., R.13W., W.M.

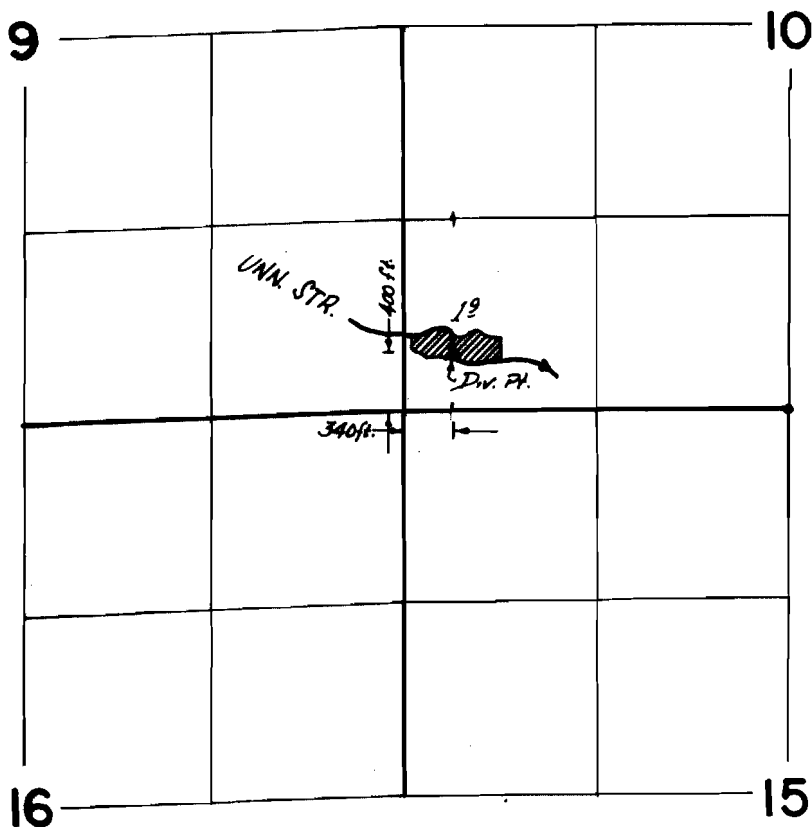

FINAL PROOF SURVEY
UNDER

Application No. 42177 Permit No. 31562
IN NAME OF

WILLIAM F. BENNIGHT

Surveyed 14 JULY 1972, by L.E. GOULD