


T.29S.&30S.R.14W.W.M.

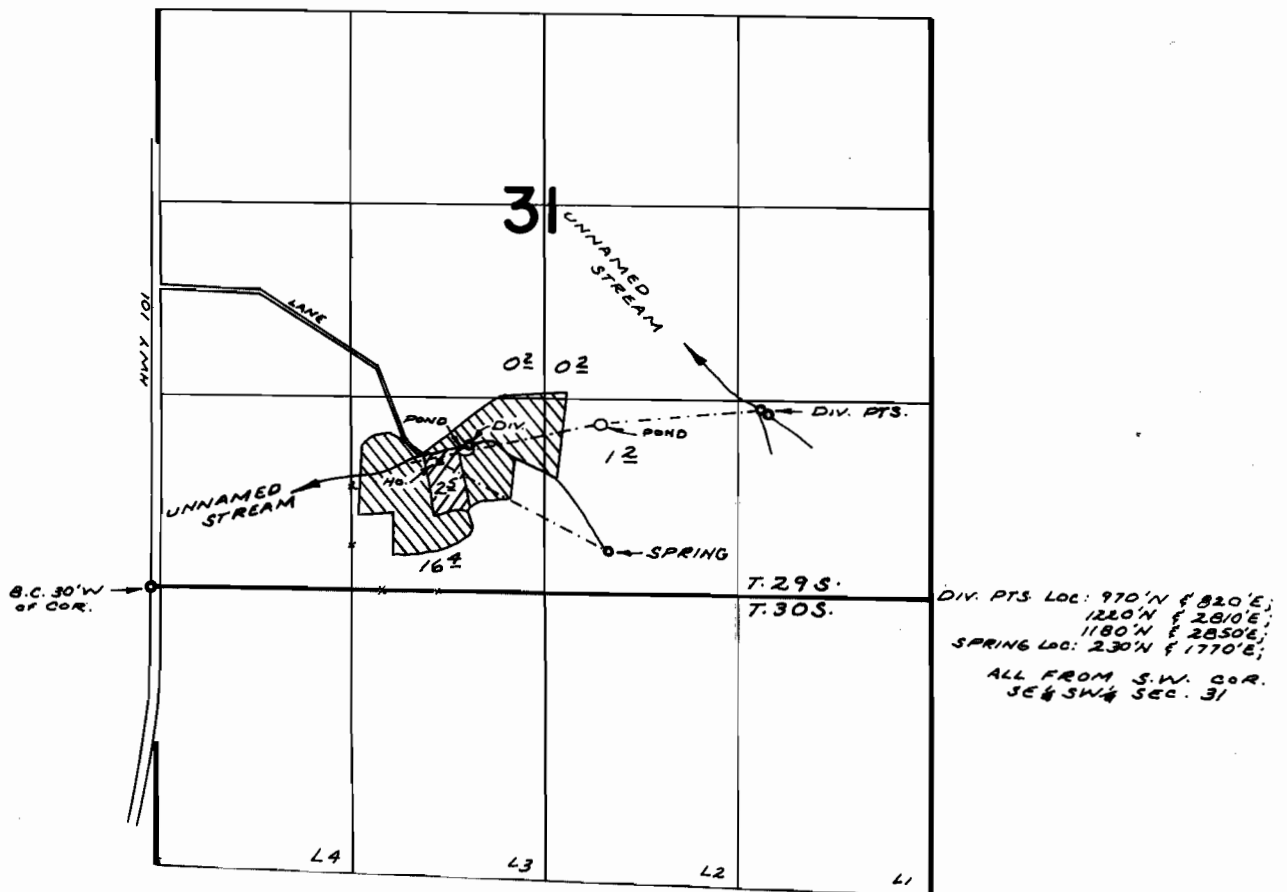

FINAL PROOF SURVEY
UNDER

Application No. 42210 42358 Permit No. 31602 31690
IN NAME OF

EDWARD T. GILMAN

Surveyed JULY 15 1972, by R. MUCKEN