


T.28S., R.13W., W.M.

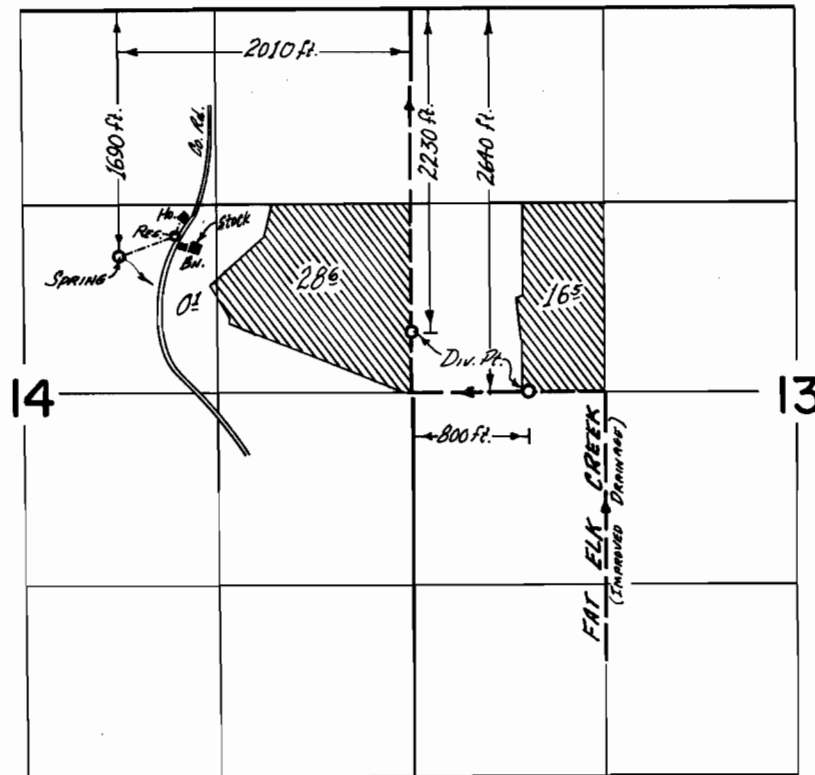

FINAL PROOF SURVEY
UNDER

Application No. 42343 Permit No. 31723
IN NAME OF

ALDO U. & ROSE MARCA

Surveyed 18 JULY 1972, by L. E. GOULD