


T.28S., R.13W., W.M.

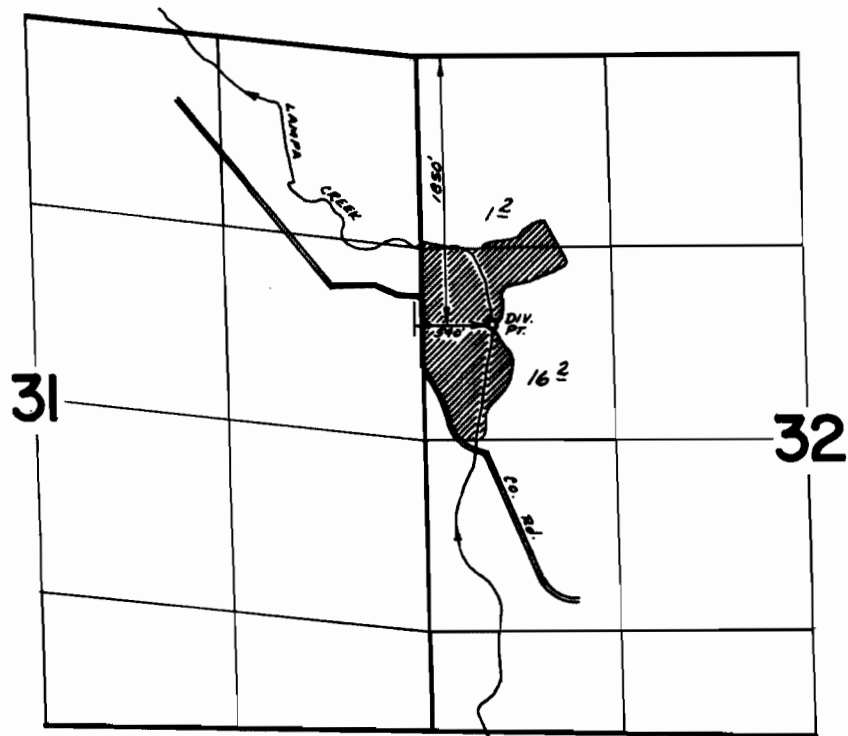

FINAL PROOF SURVEY
UNDER

Application No. 43470 Permit No. 32514
IN NAME OF

GEORGE L. PLUM

Surveyed July 18 1972, by L.E. Gould