


T.28S.,R.13W.,W.M.

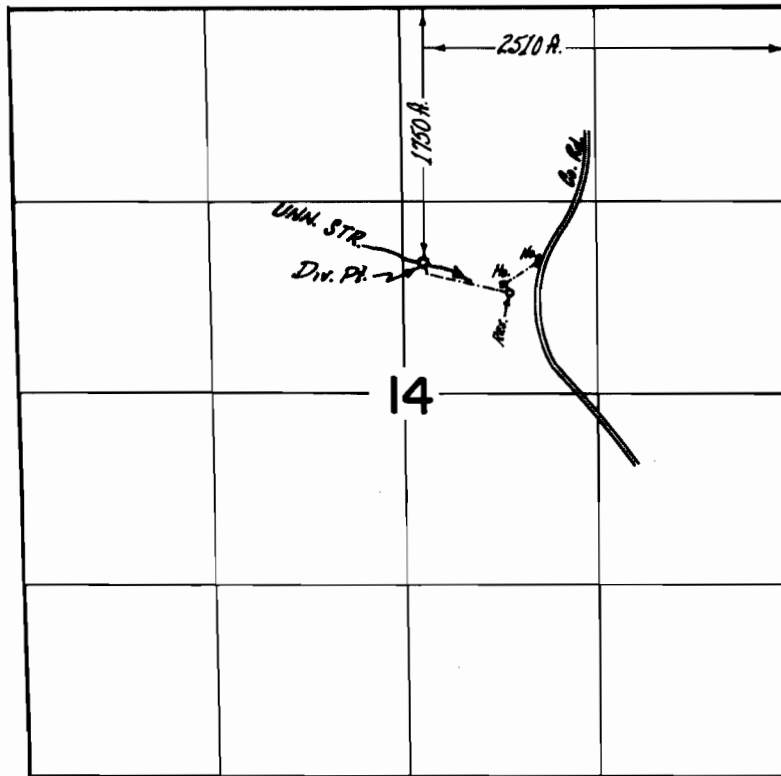

FINAL PROOF SURVEY
UNDER

Application No. 44221 Permit No. 33031
IN NAME OF

DAVID BERG and LARMIE ROBISON

Surveyed 17 JULY 1972, by L.E. GOULD