


T. 28 & 29S., R. 14 & 15W., W.M.

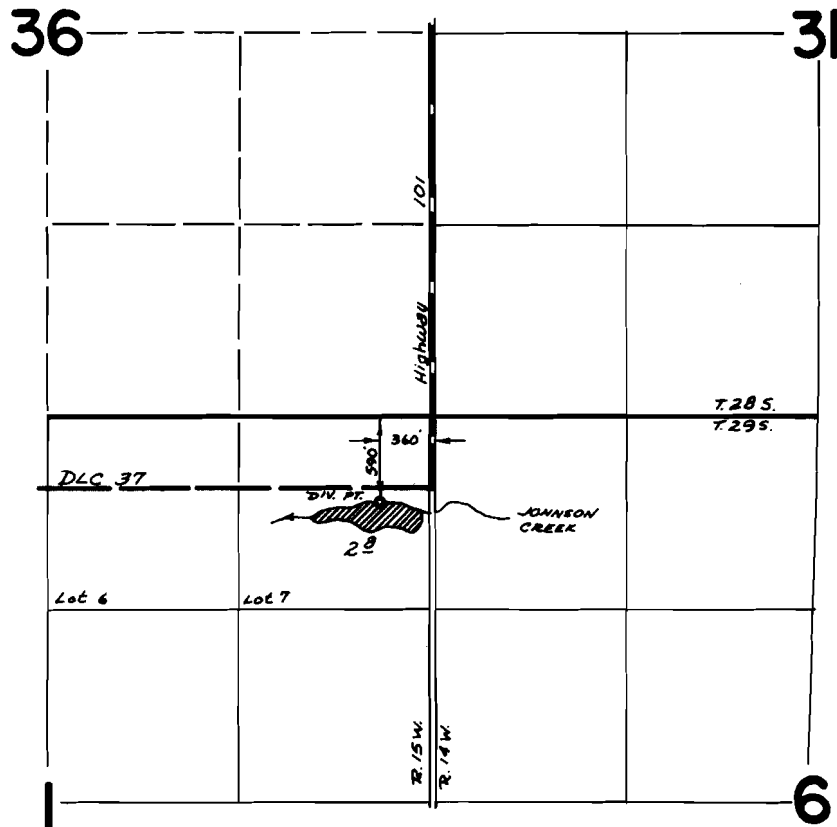

FINAL PROOF SURVEY
UNDER

Application No. 43902 Permit No. 33336
IN NAME OF

LEROY F and RUTH F HALL

Surveyed July 19 1972, by L.E. Gould