


T. 26 S. R. 13 W. W. M.

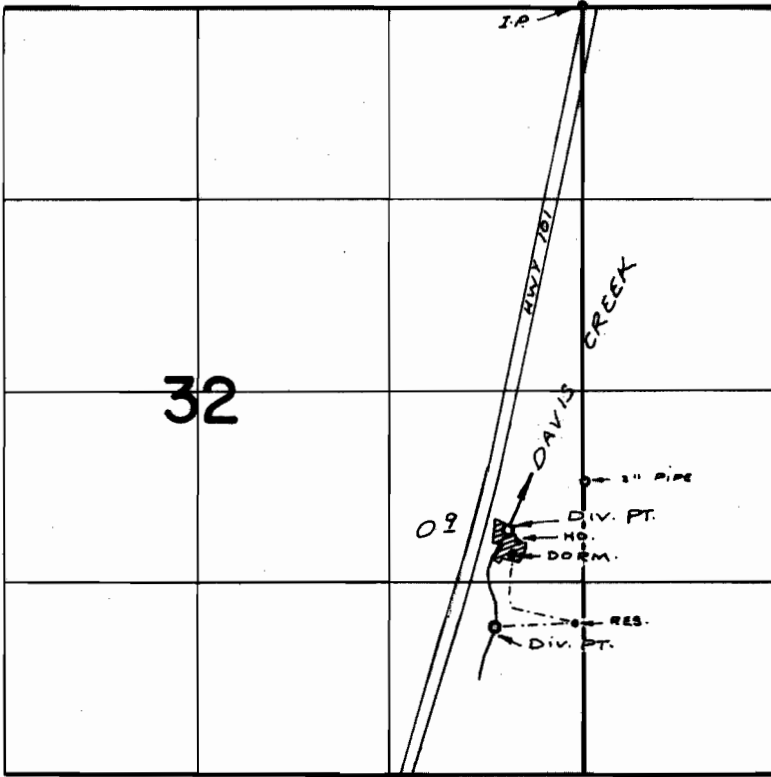

FINAL PROOF SURVEY
UNDER

Application No. 44835 Permit No. 27530
IN NAME OF
COOS COUNTY for
ROBERT C. BELLONI BOY'S FOREST RANCH
Surveyed AUG. 4, 1972, by R. MUGGEN