
## T.28 S.R.I4 W.W.M.

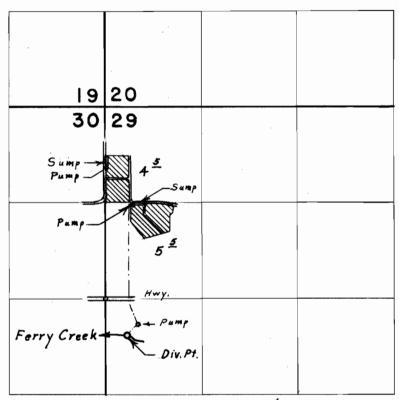

Dir. Pt. located 500'S. & 290' E. from W. & Cor. Sec. 29

## FINAL PROOF SURVEY

Application No. 44972 Permit No. 33615 IN NAME OF JIMPAT CRANBERRIES, INC.

Surveyed April 15, 1972, by L. E. Gould.