


T.27S., R.11W., W.M.

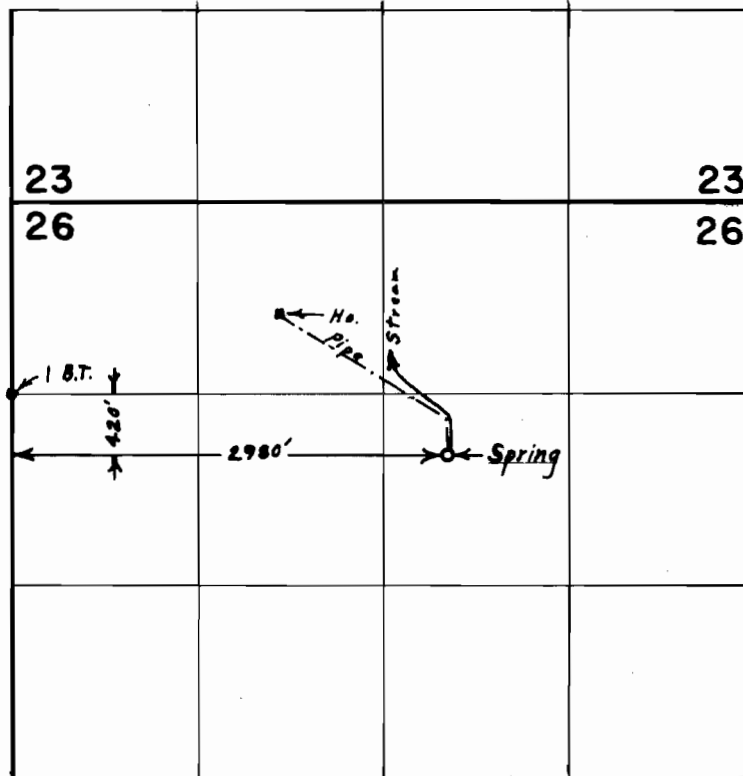

**FINAL PROOF SURVEY**  
UNDER

Application No. 45066 Permit No. 33641  
IN NAME OF

ROY V. ENLAND

Surveyed July 10, 1972, by L. E. Gould