


T. 29 S., R. 14 W., W. M.

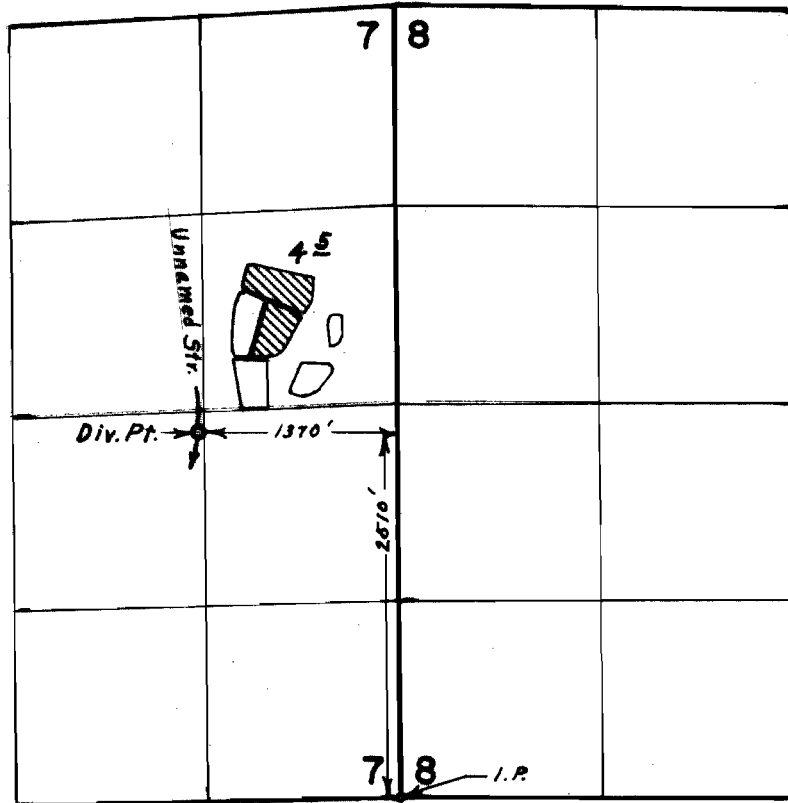

FINAL PROOF SURVEY
UNDER

Application No. 45442 Permit No. 33914
IN NAME OF

H. R. INKS

Surveyed April 19, 19....., by L. E. Gould