


T. 28 & 29 S. R. 14 W. W.M.

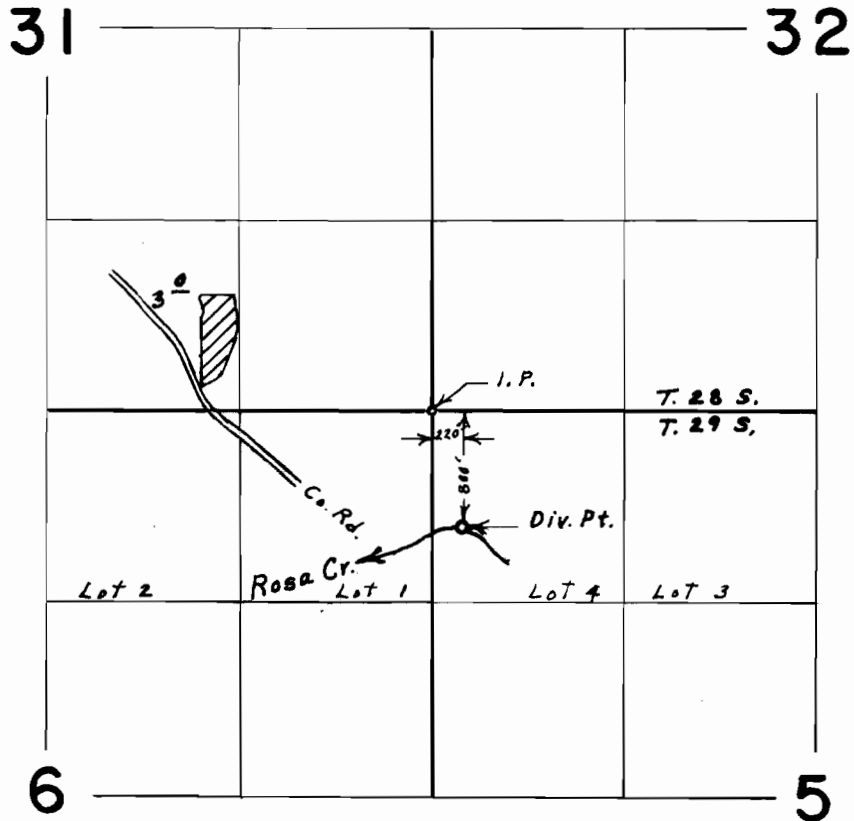

FINAL PROOF SURVEY
UNDER

Application No. 45203 Permit No. 33769
IN NAME OF

WARREN HAWKINS

Surveyed April 13, 1972, by L. E. Gould