


T.27S.,R.13W.,W.M.

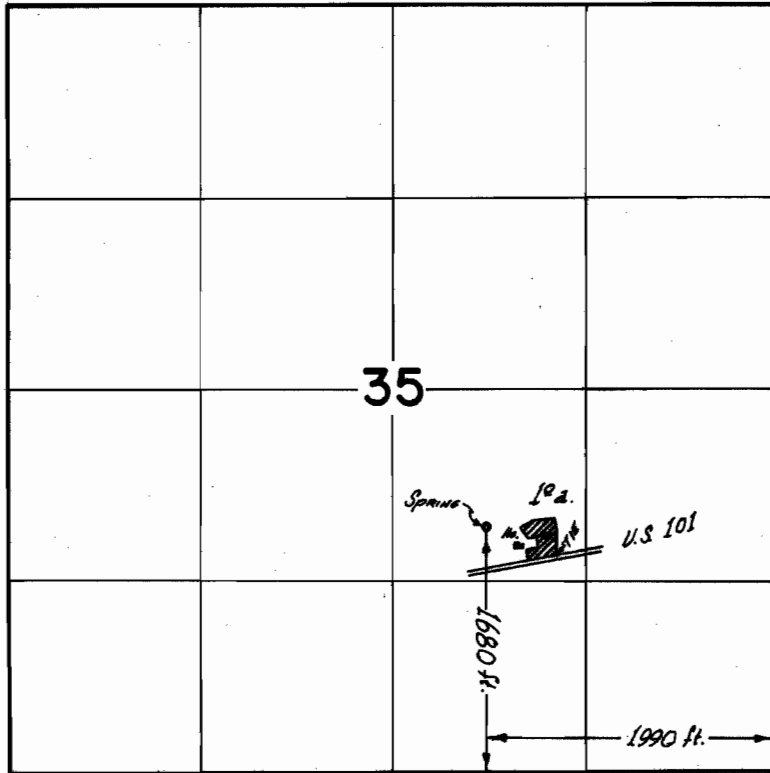

**FINAL PROOF SURVEY**  
UNDER

Application No. 47611 Permit No. 35636  
IN NAME OF

DONALD E. HYDE

Surveyed 14 JULY 1972, by L.E. GOULD