


T.29 S., R.14 W., W.M.

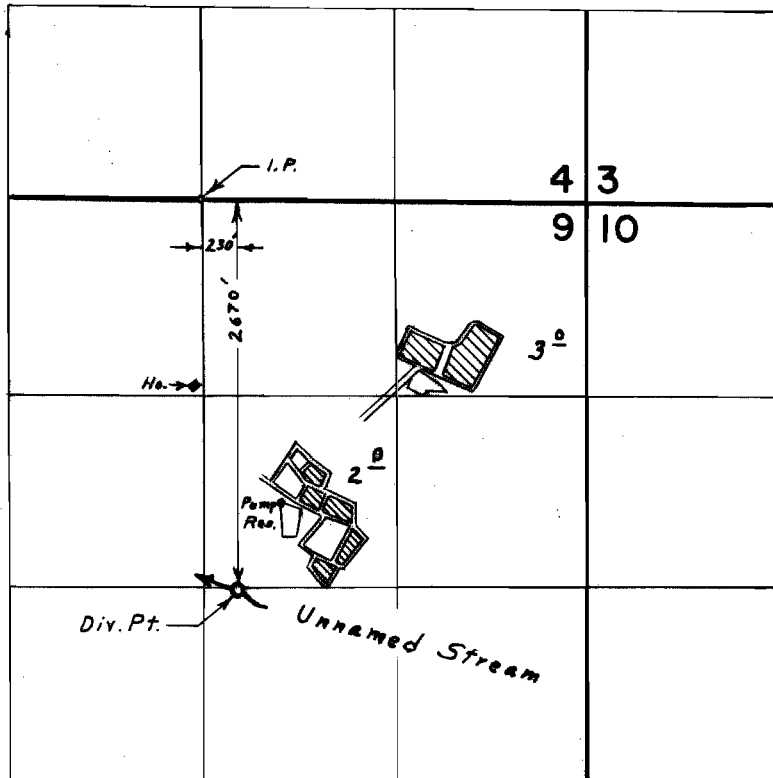

**FINAL PROOF SURVEY**  
UNDER

Application No. 46863 Permit No. 35039  
IN NAME OF  
**ESTATE OF ERWIN F. RICHART**

Surveyed April 20, 1972., by L. E. Gould.