


T.29S.R.12W.W.M.

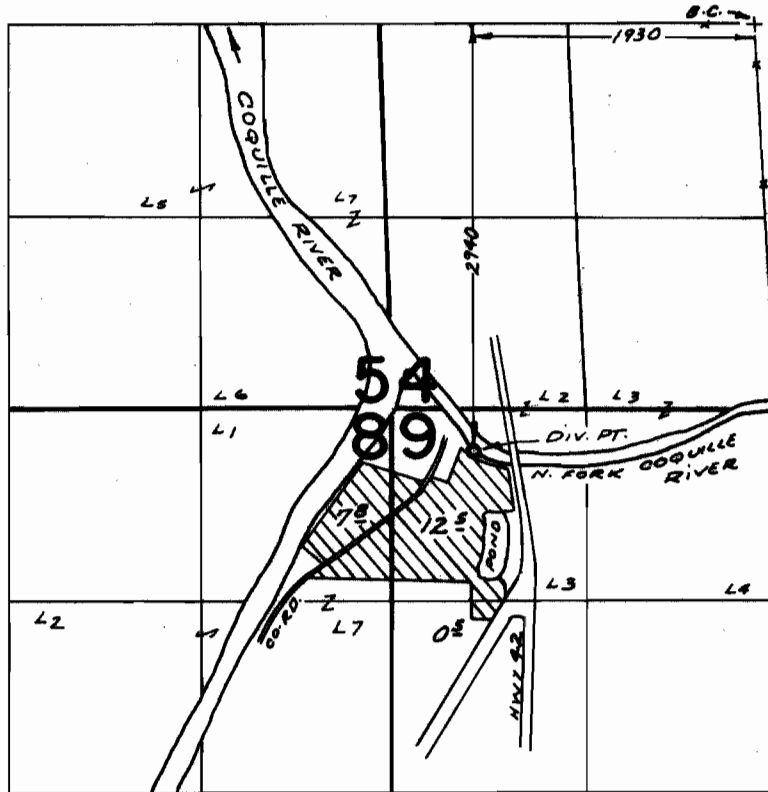

FINAL PROOF SURVEY
UNDER

Application No. 46959 Permit No. 35137
IN NAME OF

JAMES A. LEIBELT

Surveyed JULY 17 1972, by R. MUCKEN