


T. 23 S. R. 12 W. W.M.

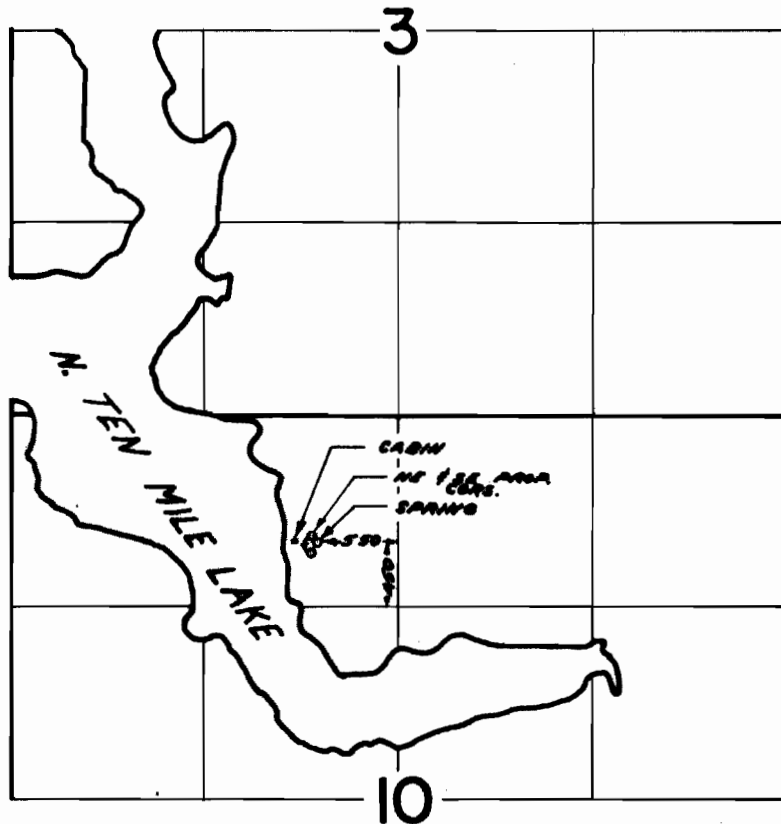

FINAL PROOF SURVEY
UNDER

Application No. 17385 Permit No. 35401
IN NAME OF

GLENN T. & MARIAN BEELMAN

Surveyed AUG. 9 1972, by R.G. MUEHLEN