


T. 29 S. R. 14 W. W. M.

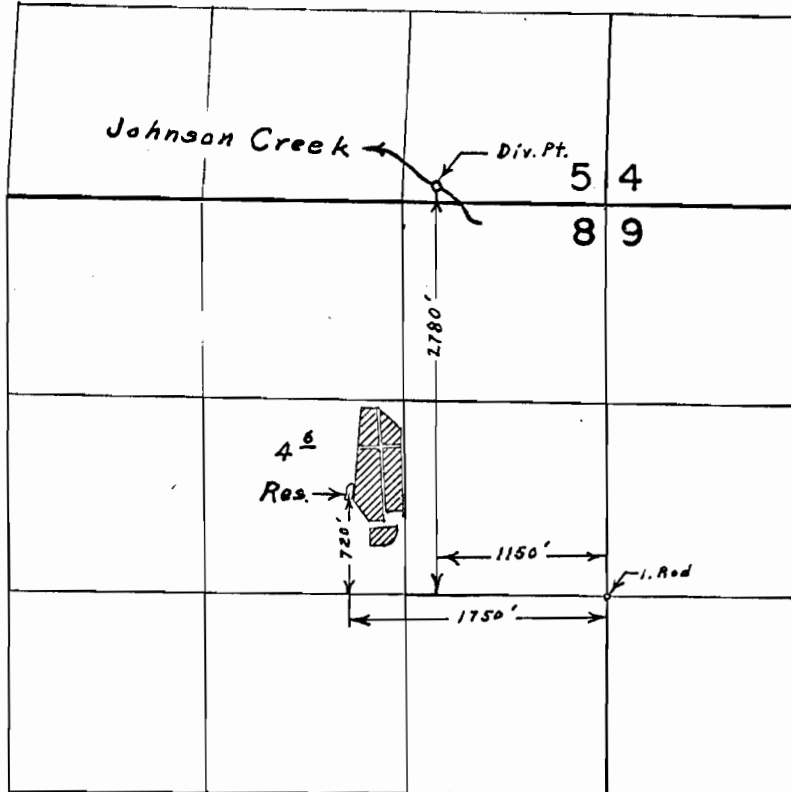

FINAL PROOF SURVEY UNDER

R-43421 R-4984
Application No. 43422 Permit No. 32463
IN NAME OF

GEORGE HAWKINS

Surveyed *April 12, 1972*, by *L. E. Gauld*