


T. 29 S. R. 14 W. W. M.

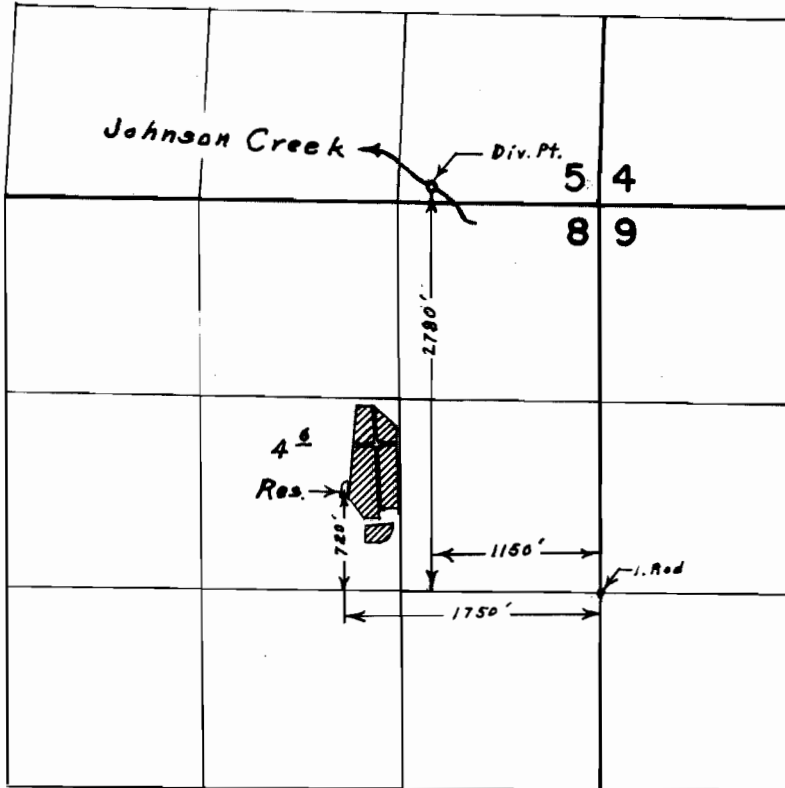

FINAL PROOF SURVEY
UNDER

R-43421 R-4984
Application No. 43422 Permit No. 32463
IN NAME OF

GEORGE HAWKINS

Surveyed April 12, 1972, by L. E. Gould