


T.2S. R.5E. W.M.

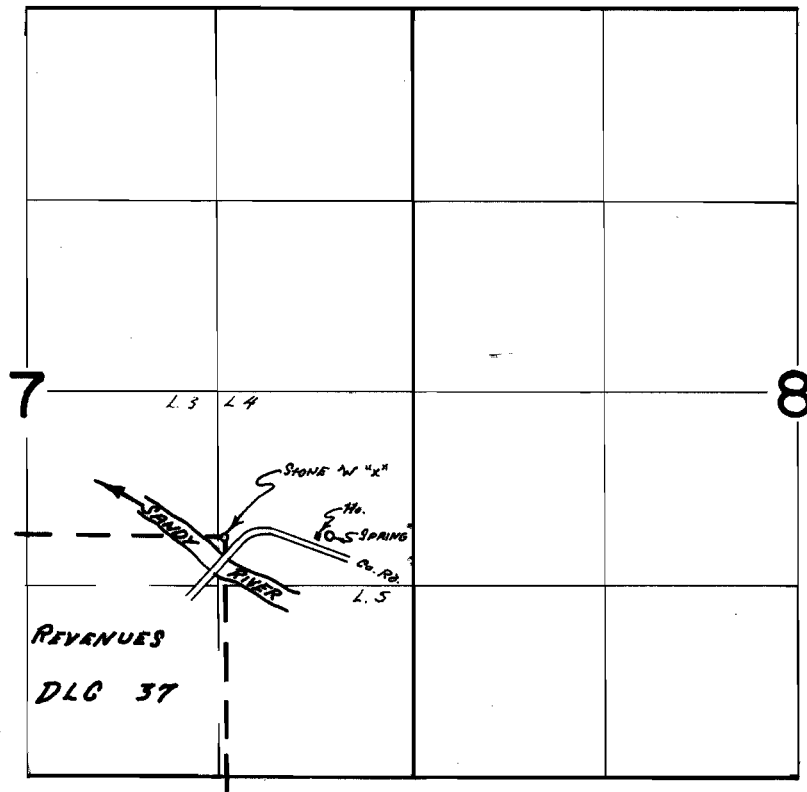

SPRING LOC. 10' N & 730' E FROM NE COR REVENUES DLG 37

FINAL PROOF SURVEY
UNDER

Application No. 47432 Permit No. 35514
IN NAME OF

DORIS E. WILLIAM P. BROCKNER

Surveyed May 22 1972, by R.B. MUCKEN