


T.21S.R.12W.W.M.

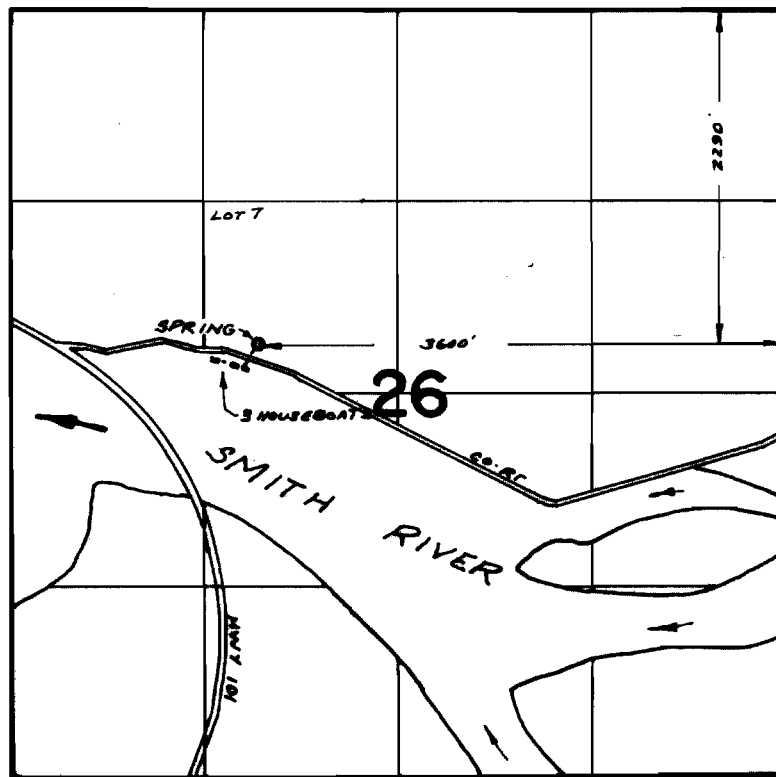

FINAL PROOF SURVEY
UNDER

Application No. 45857 Permit No. 34237
IN NAME OF

AL EGELAND

Surveyed AUG. 11, 1972, by R. MUCKEN