


RECEIVED  
SEP 21 1970  
STATE ENGINEER  
SALEM, OREGON

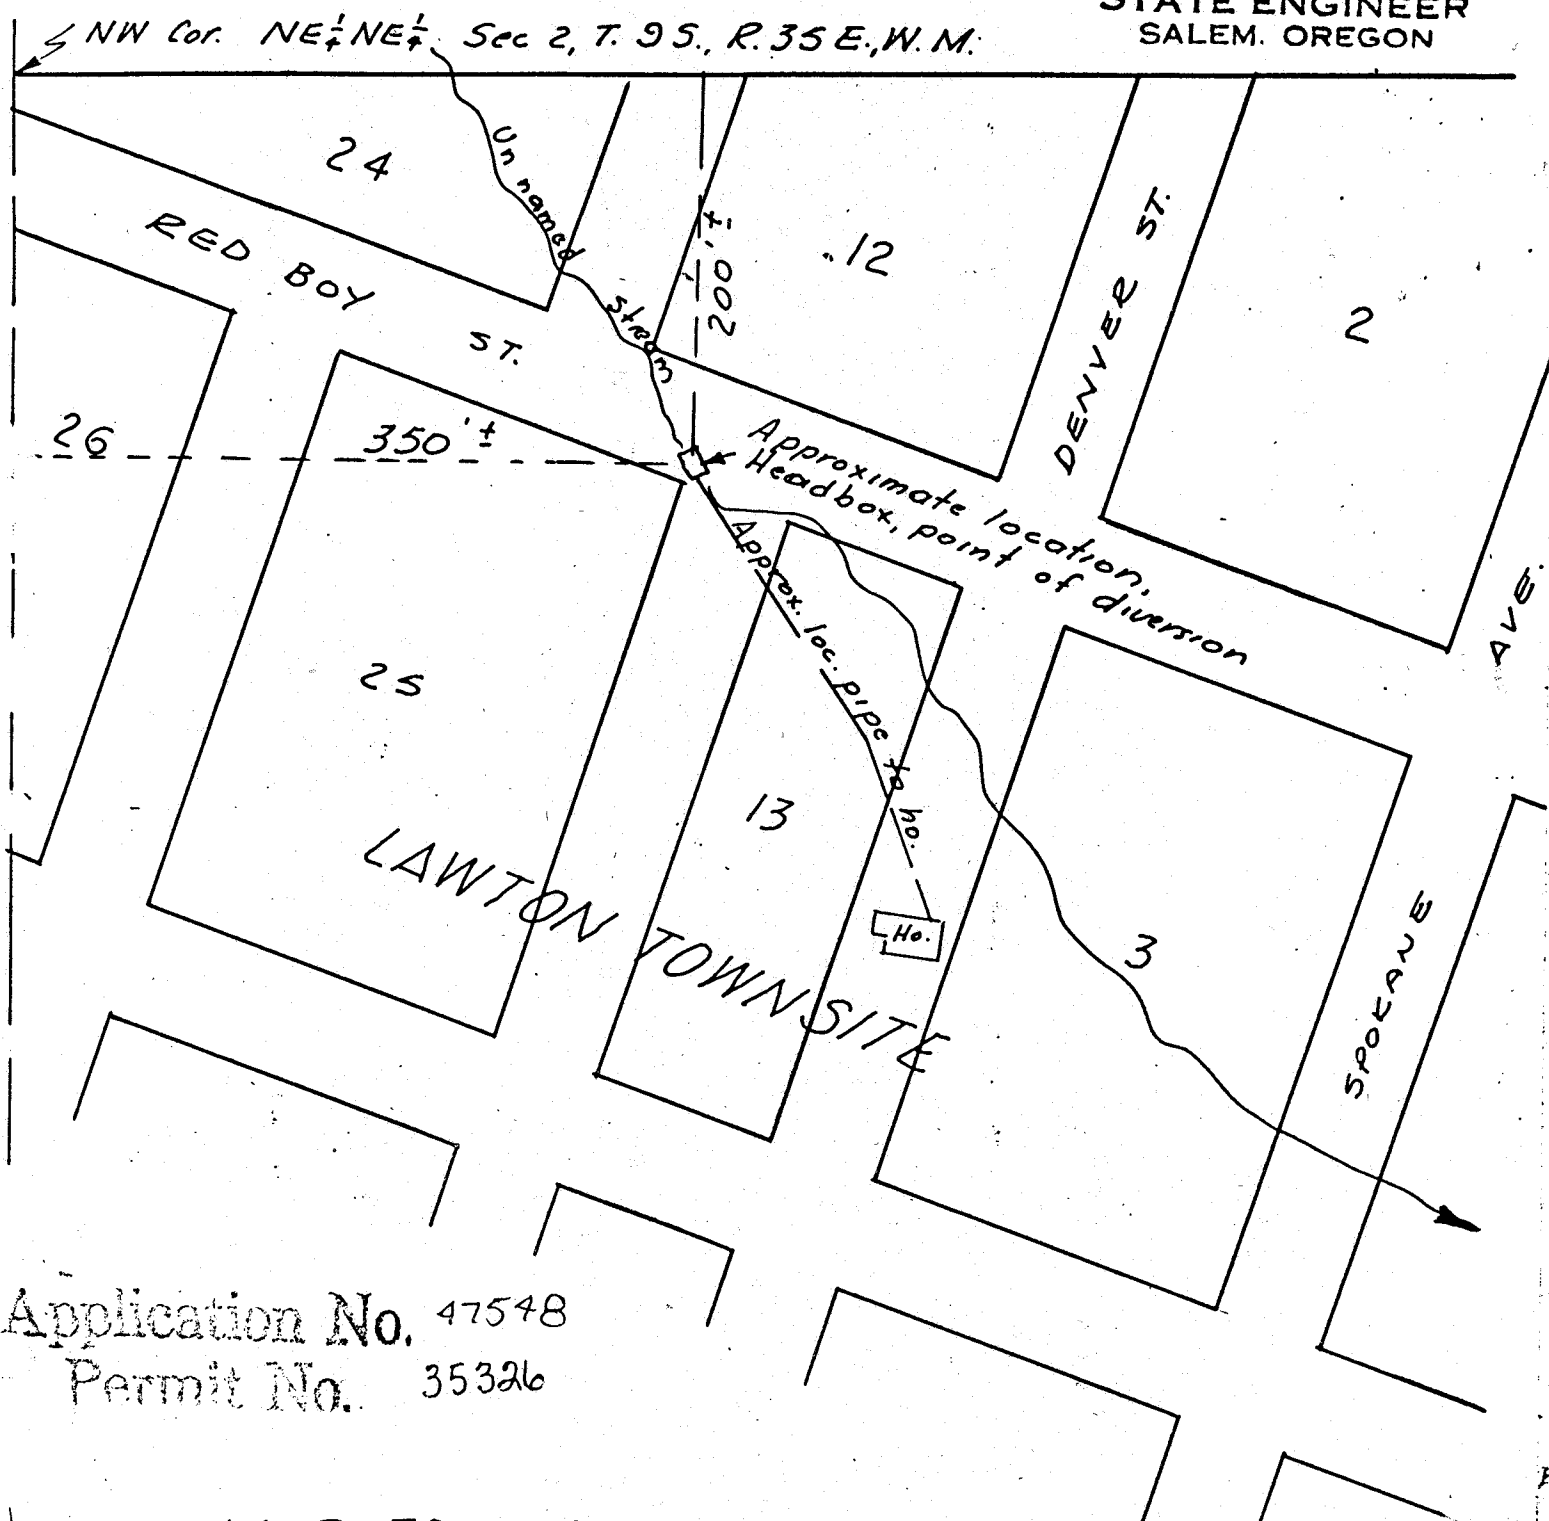

Application No. 47548  
Permit No. 35326

MAP TO ACCOMPANY APPLICATION  
FOR WATER PERMIT

Scale 1" = 100'

Sept. 1970

James C. Maddox, Applicant.

39536