


T. 37 & 38 S. R. 2 W. W. M.

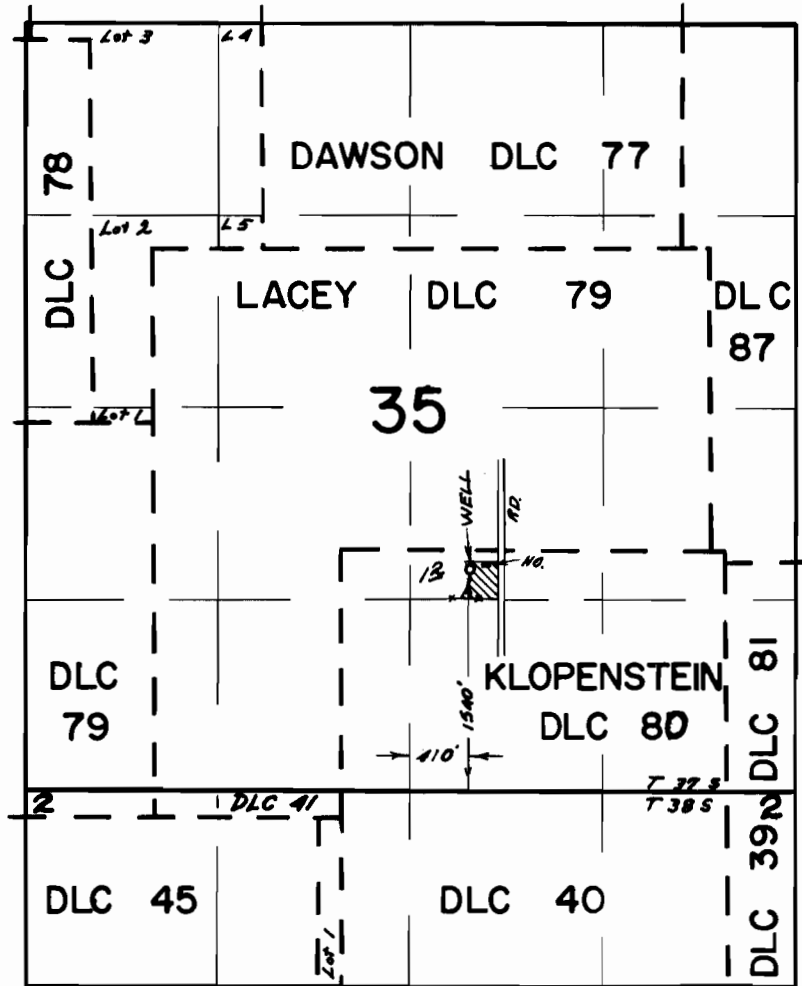

**FINAL PROOF SURVEY**  
UNDER

Application No. G-3815. Permit No. G-3598.  
IN NAME OF

L. G. FRINK

Surveyed OCT. 12, 1971., by R. MUCKEN