




T.40S., R.8W., W.M.

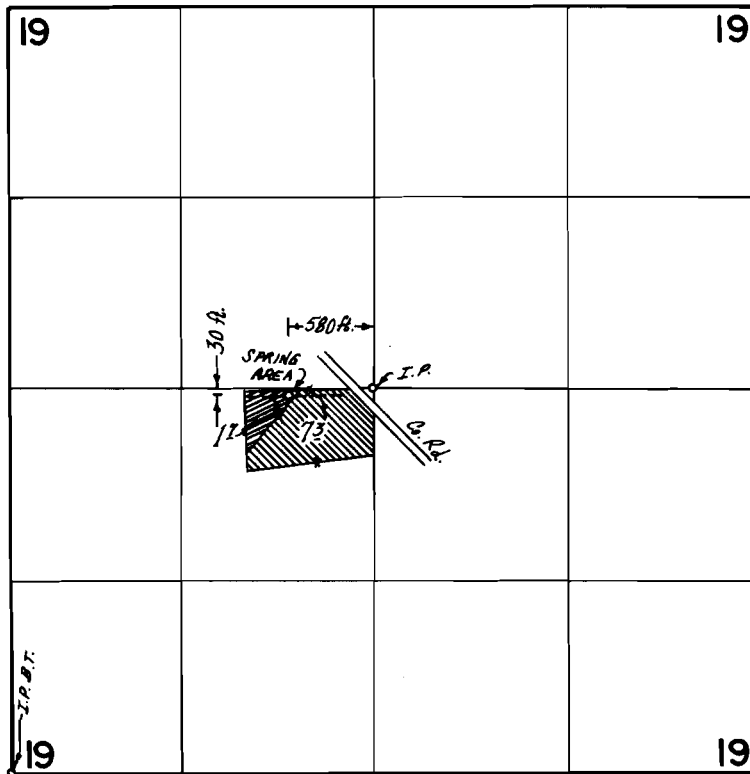

 PRIMARY
 SUPPLEMENTAL

FINAL PROOF SURVEY
UNDER

Application No. 40764 Permit No. 30383
IN NAME OF

CHARLIE A. TREFETHEN

Surveyed 31 Oct. 1972, by L.E. GOULD