


T. 39 S. R. 20 E. W.M.

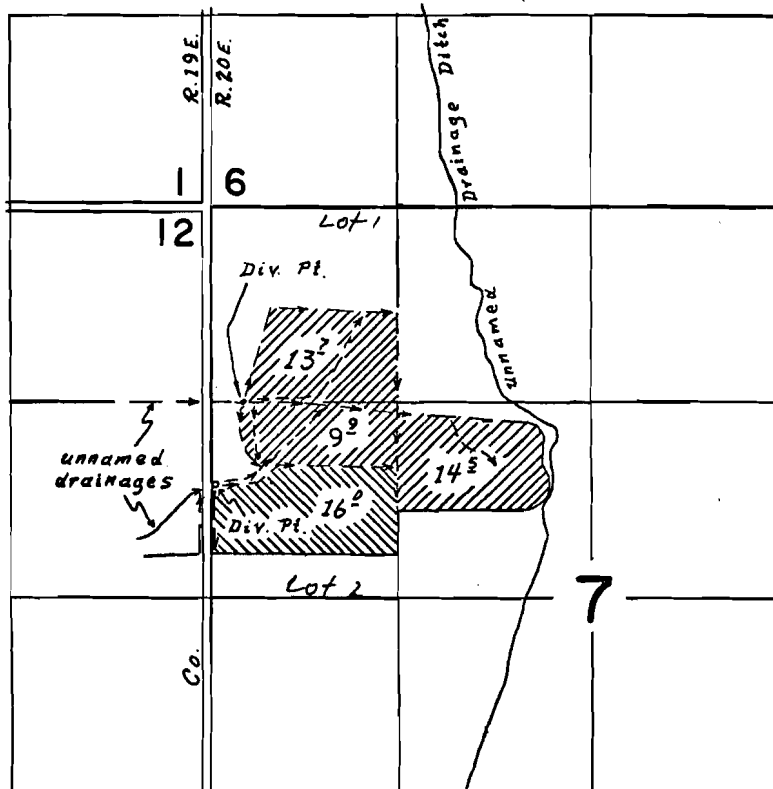

Div. Pt. under A# 43712 1330'S. 1250'E.
Div. Pt. under A# 43713 1890'S. 50'E. All Loc. from N.W. Cor. Sec. 7

FINAL PROOF SURVEY
UNDER

43712

32802

Application No. 43713 Permit No. 32803
IN NAME OF

Benner E. Cox

Surveyed 20 Sept 1972, by L. E. Gould

C-39540

39541