


T. I.S.R. I.W. W.M.

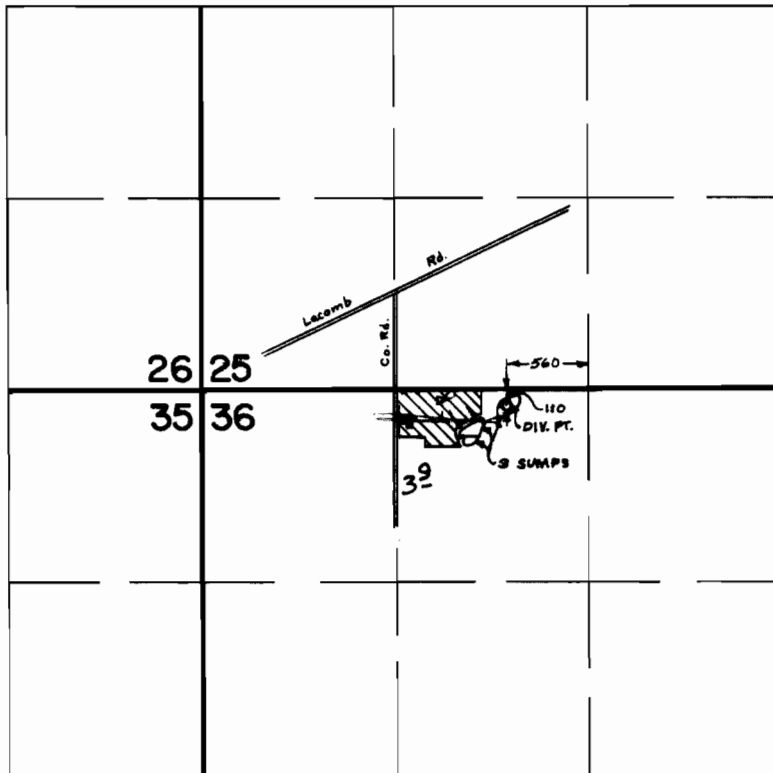

FINAL PROOF SURVEY UNDER

Application No. G-4385 Permit No. G-4137
IN NAME OF

JOHN D. and LETHA M. SHIVELY

Surveyed JUNE 2 1972, by D. BUELL