


# T. 7S. R. 1W. W.M.

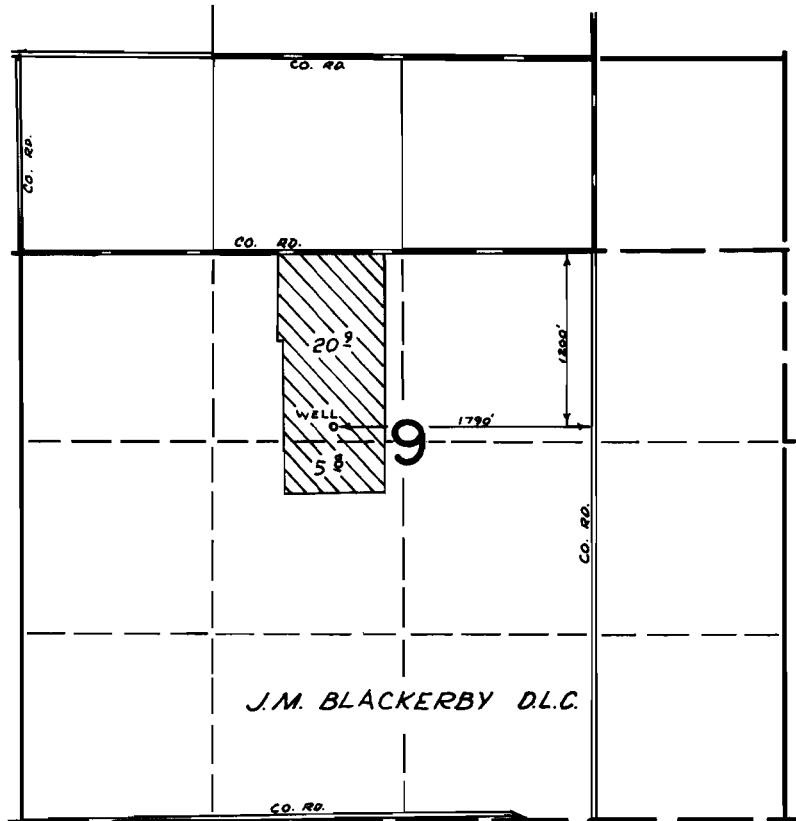

## FINAL PROOF SURVEY UNDER

Application No. G-4810 Permit No. G-4533  
IN NAME OF

GARY KAUFMAN

Surveyed APRIL 17 1972, by D. Norby