
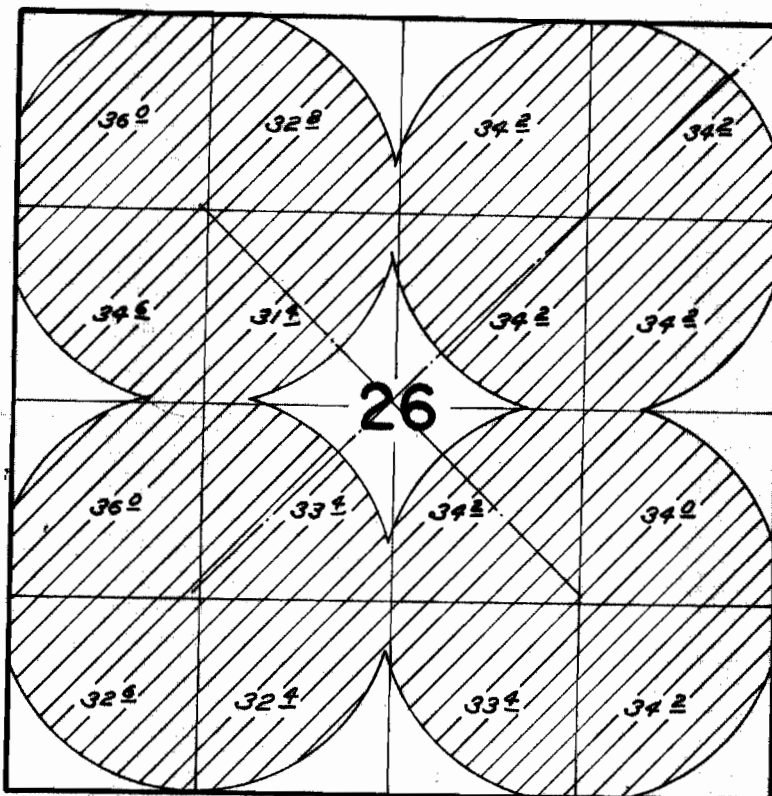


T.5N.R.27E.W.M.

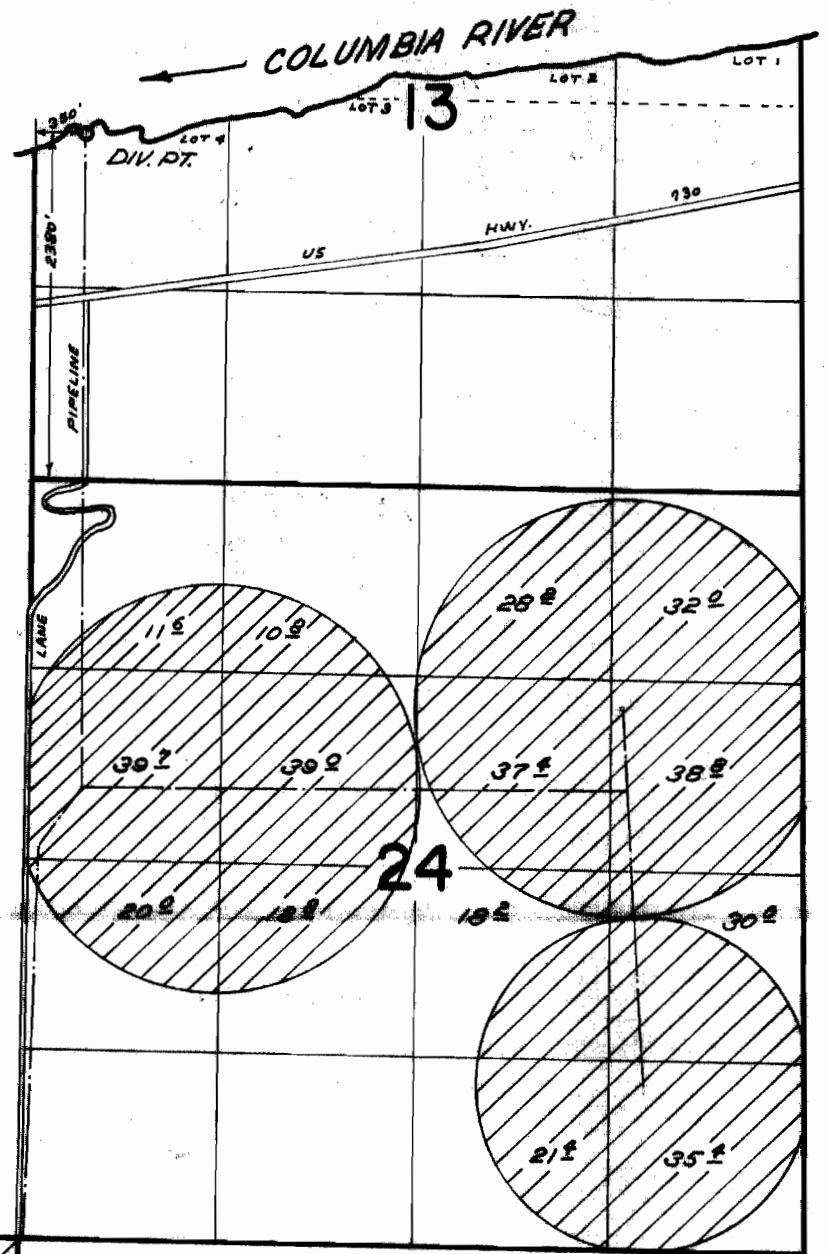

# FINAL PROOF SURVEY

UNDER

Application No. 43817, Permit No. 32487

IN NAME OF

**RAYMOND DUNN AND  
WILLIAM McCLANNAHAN**

Surveyed April 17, 1973, by L. E. GOULD