T. 4 & 5 S., R. 4 W., W.M.

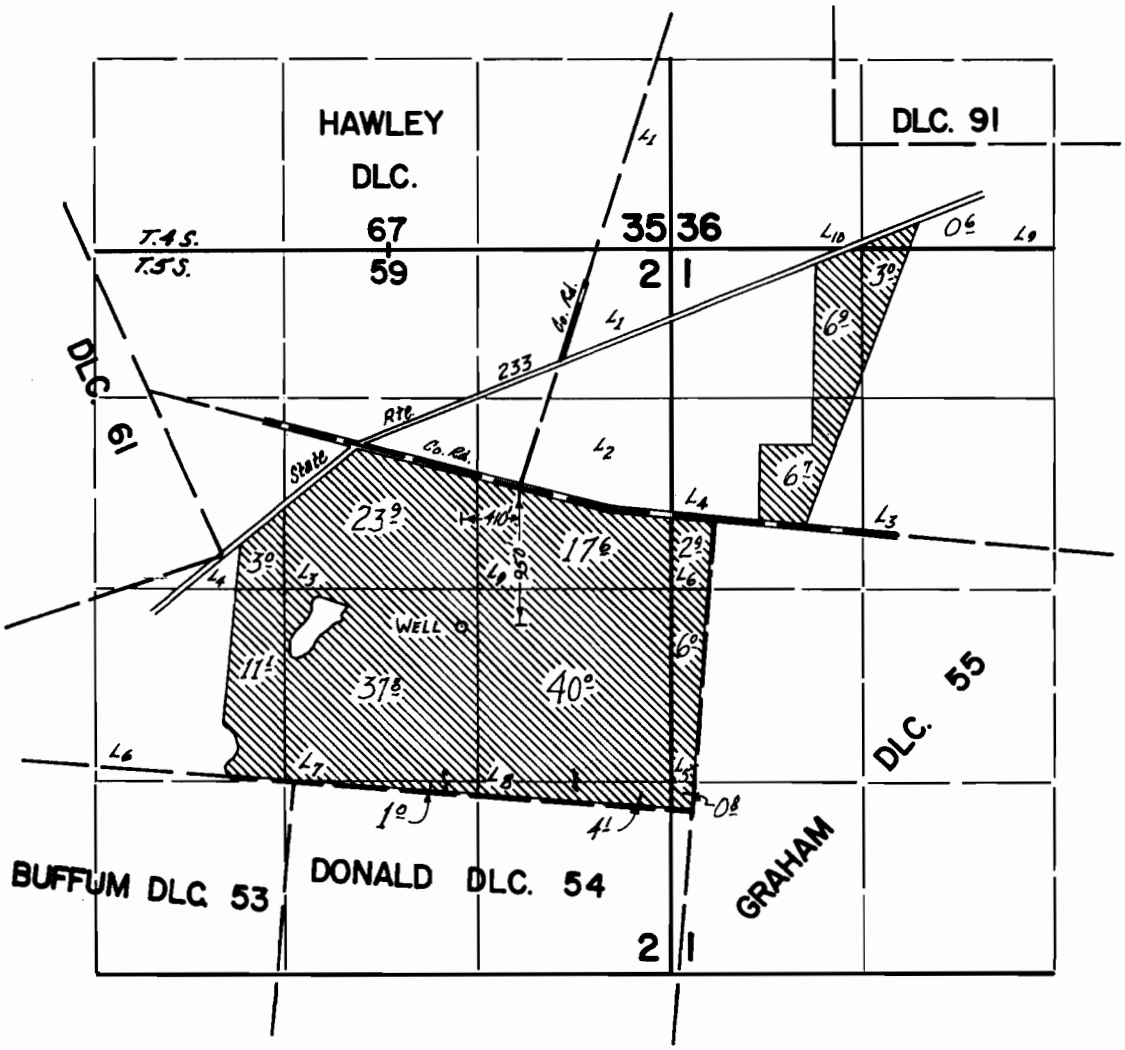

FINAL PROOF SURVEY
UNDER

Application No. G-3546 Permit No. G-3335
IN NAME OF

VICTOR BROWN

Surveyed 10 Nov. 1972, by D. Norby

DFQ-2LL-163