T.5 S., R.3 W., W.M.

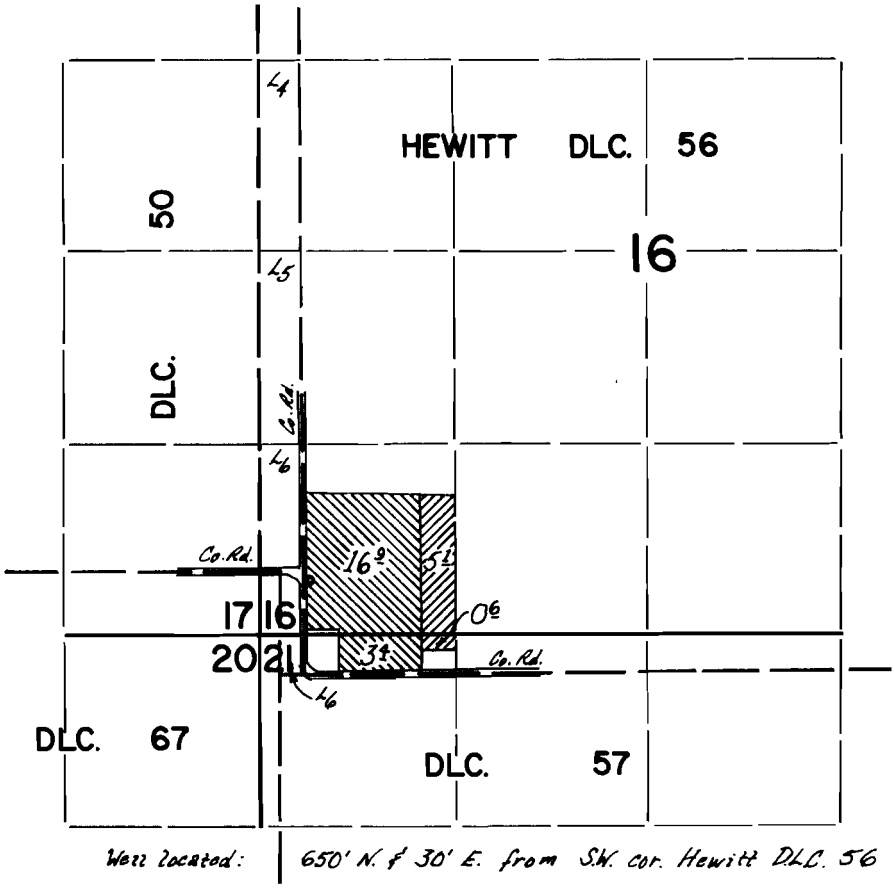

FINAL PROOF SURVEY

UNDER

G-4305 → G-4066
G-3904 → G-3668

Application No. ..... Permit No. .....

IN NAME OF

CLARK NOBLE

Surveyed 19 MAY 19 72, by D. NORBY

DFQ-5D-31 & DFQ-2LL-219