


T.5S., R.4W., W.M.

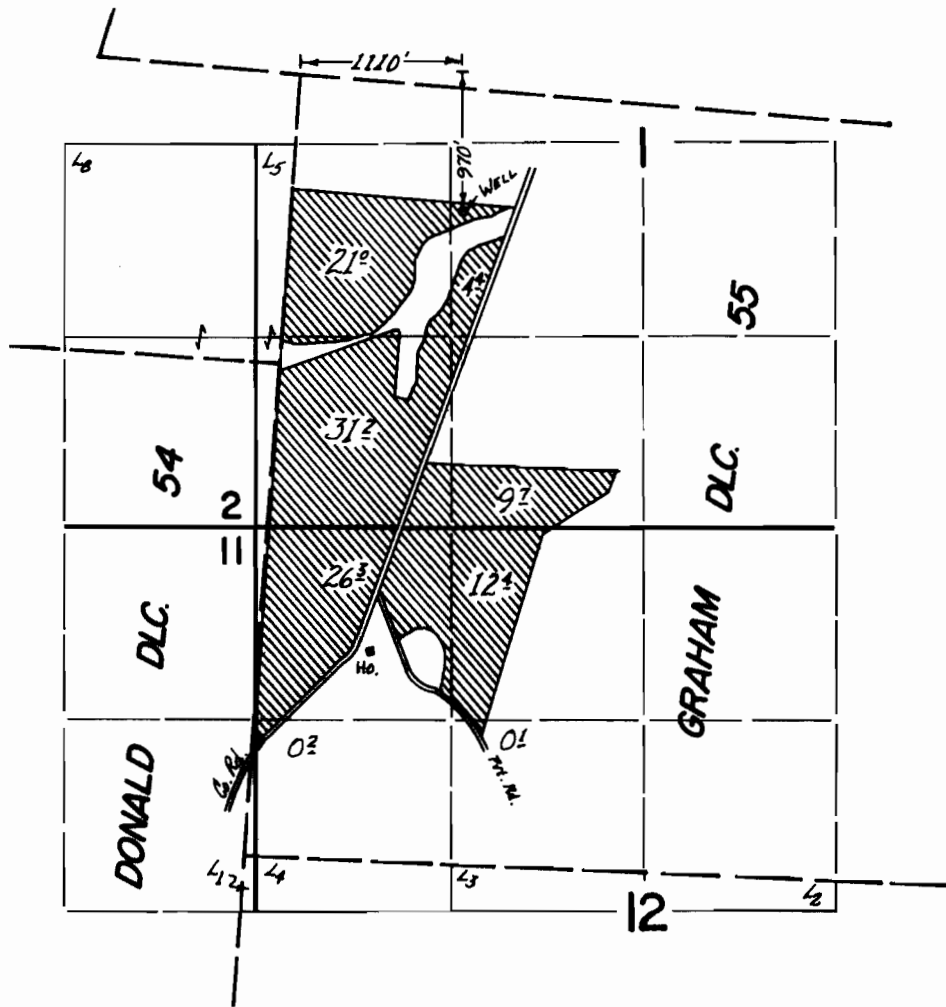

FINAL PROOF SURVEY
UNDER

Application No. G-3951 Permit No. G-3708
IN NAME OF

O. C. YOCOM, Jr.

Surveyed 13 Nov. 19 72, by D NORBY