


T.5S., R.3W., W.M.

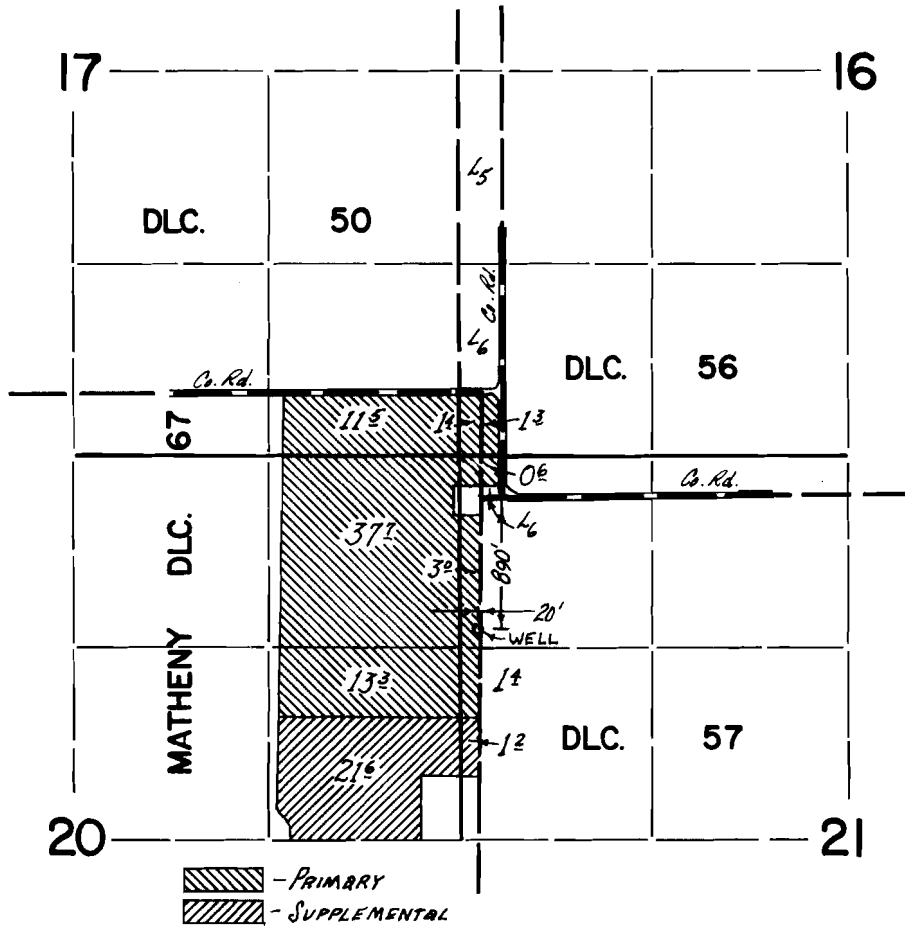

FINAL PROOF SURVEY
UNDER

Application No. G-4161 Permit No. G-3863
IN NAME OF

JAMES C. SHELBURNE

Surveyed 8 Nov. 1972, by D. NORBY