


T.5S., R.3W., W.M.

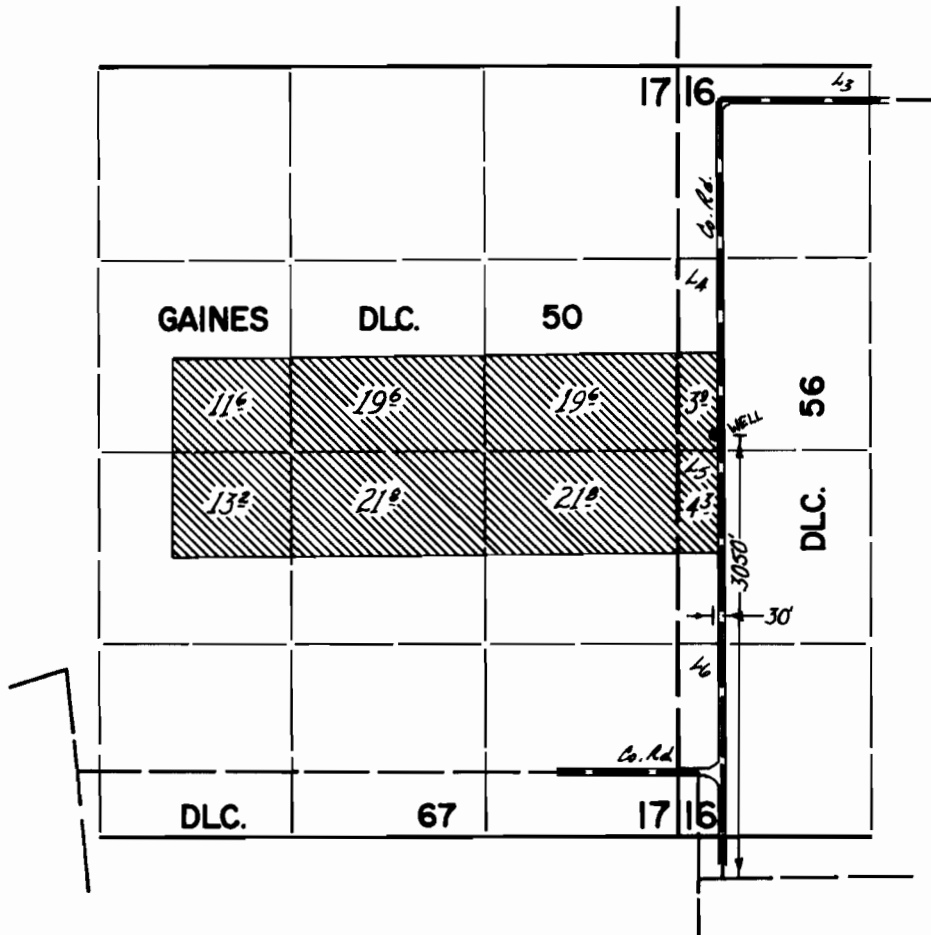

FINAL PROOF SURVEY
UNDER

Application No. G-3882 Permit No. G-4229
IN NAME OF

FRED L. & MARGARET WITHEE

Surveyed 18 May 1972, by D. NORBY