


T.5S., R.4W., W.M.

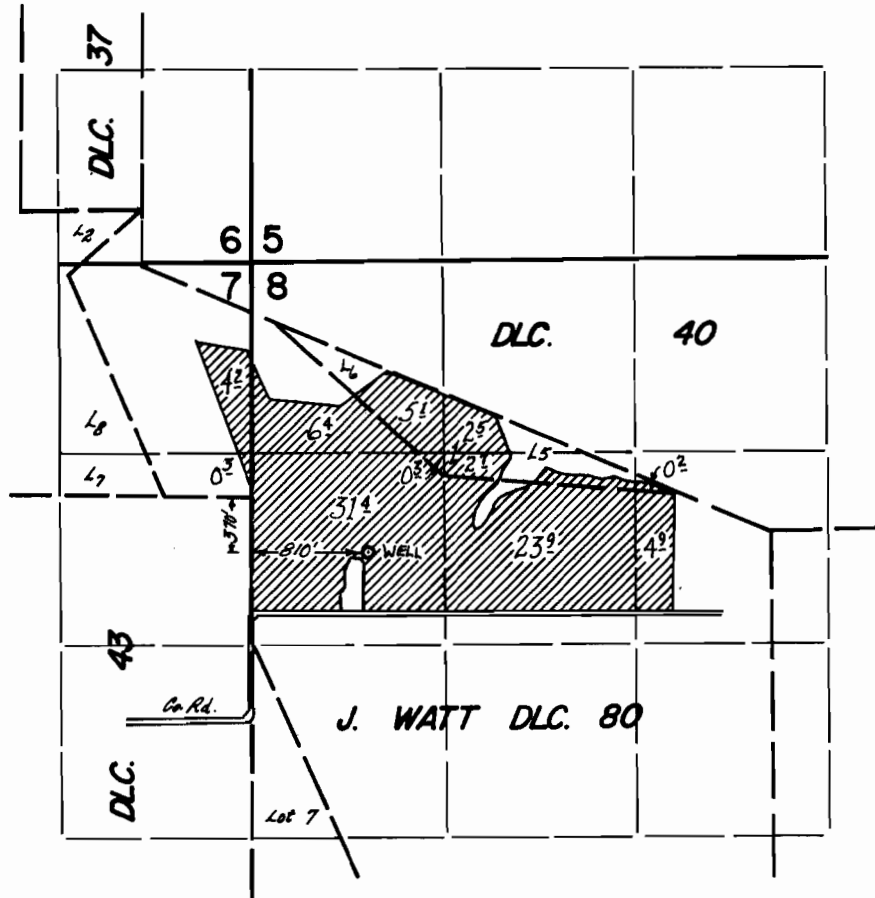

FINAL PROOF SURVEY
UNDER

Application No. G-4657 Permit No. G-4381
IN NAME OF

BERNICE C. LAWSON

Surveyed 13 Nov 1972, by D. NARBY