


T.5S., R.3W., W.M.

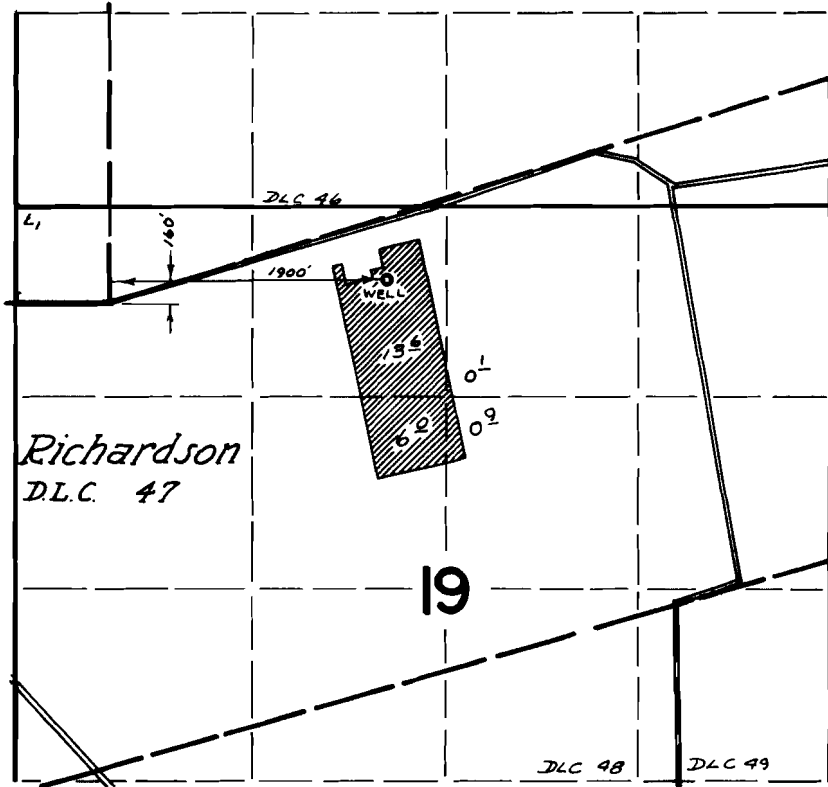

FINAL PROOF SURVEY
UNDER

Application No. G-5068 Permit No. G-4785
IN NAME OF

CARL DRAWDY

Surveyed May 17 1972, by D. Norby