


T.5S., R.3W., W.M.

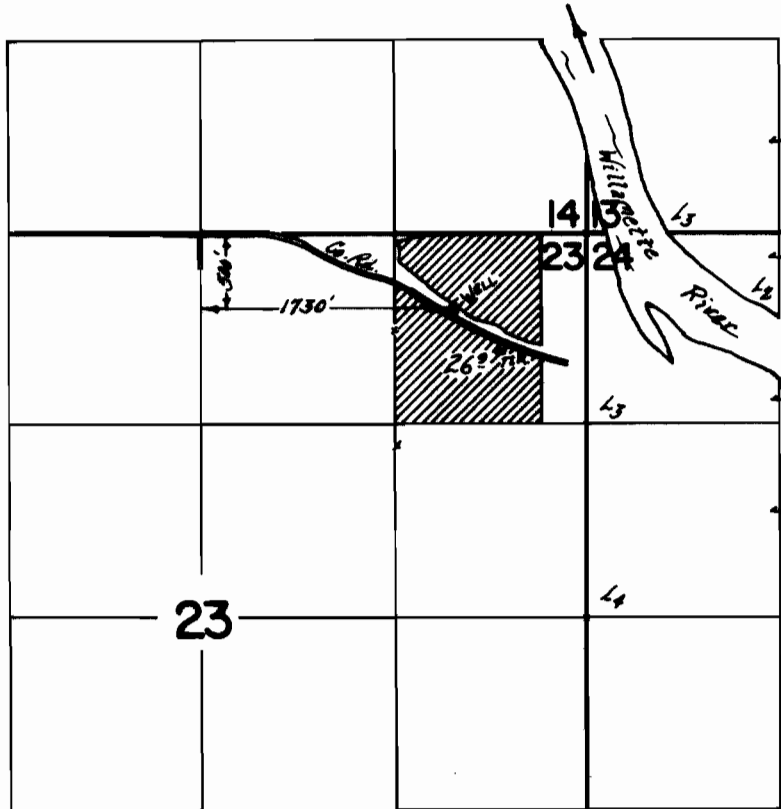

**FINAL PROOF SURVEY**  
UNDER

Application No. G-5786 Permit No. G-4990  
IN NAME OF

DAN TOMPKINS

Surveyed 8 Nov. 1972, by D. NORBY