


T.5&6S.,R.5W.,W.M.

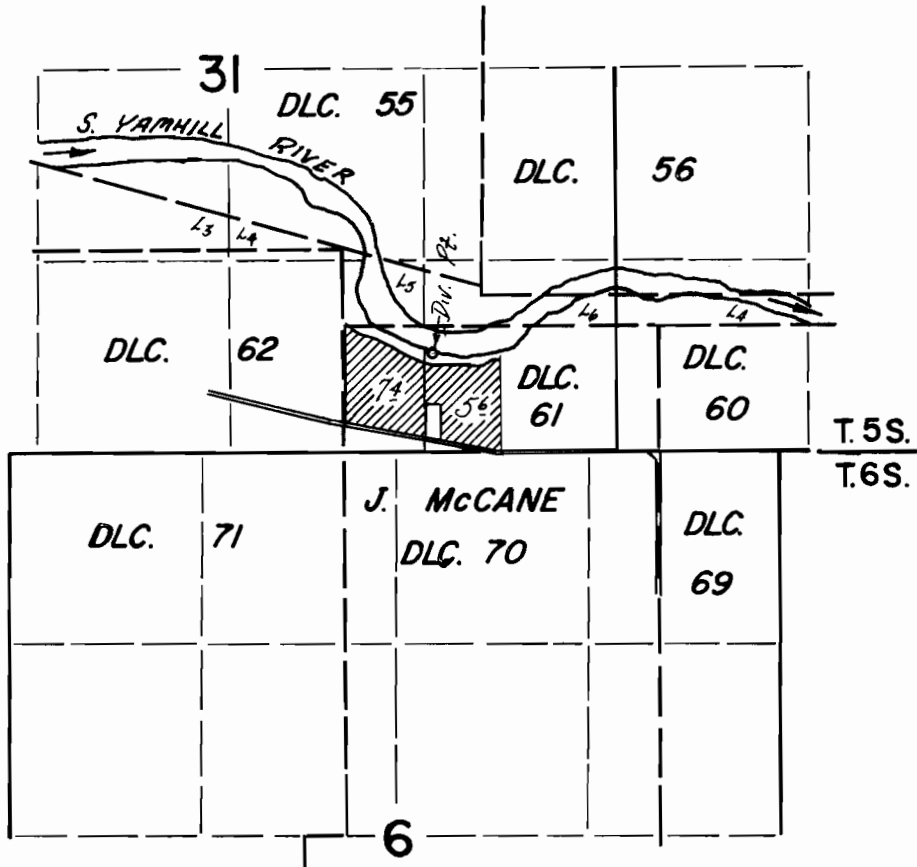

Div. Pt. Located 180' S. & 590' E. FROM NW COR. McCANE D.L.C. 61

FINAL PROOF SURVEY
UNDER

Application No. 41895 Permit No. 31047
IN NAME OF

DAVID STUTZMAN

Surveyed 24 JULY 19 72, by D. NORBY