


T.5S., R.5W., W.M.

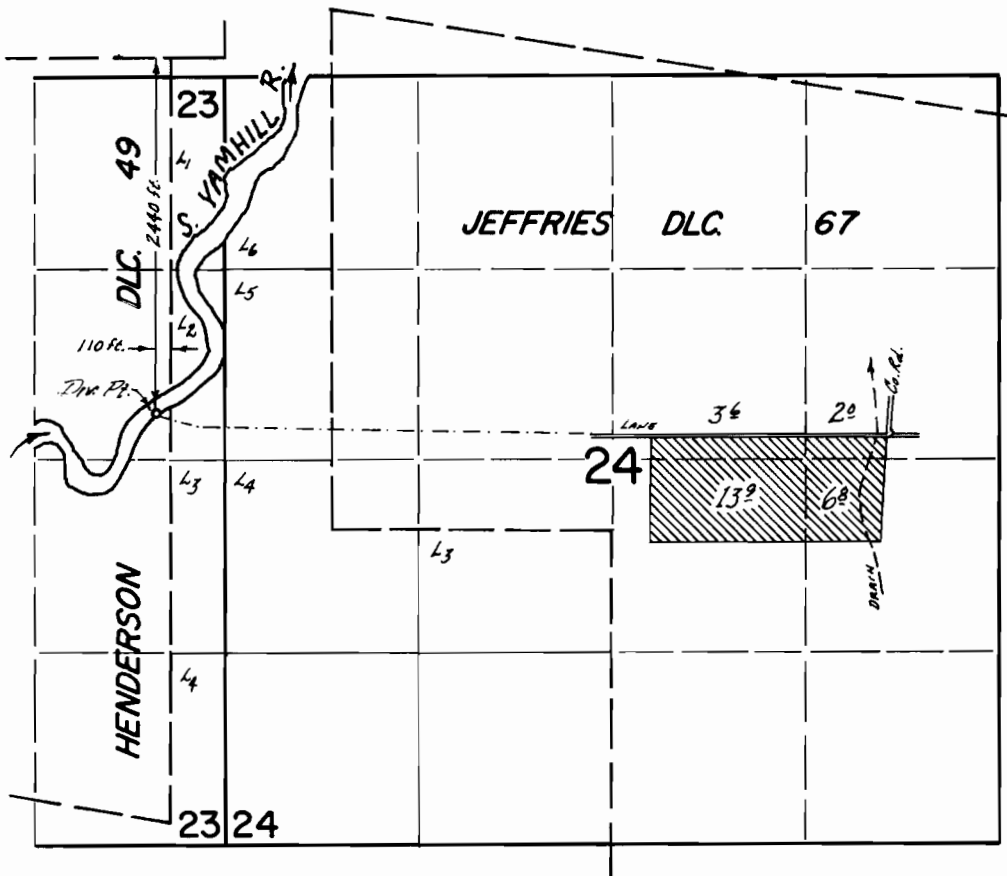

FINAL PROOF SURVEY
UNDER

Application No. 43225 Permit No. 32316
IN NAME OF

LEHMAN BROS.

Surveyed 28 JULY 19 72, by D. NORBY