


T.5S., R.5W., W.M.

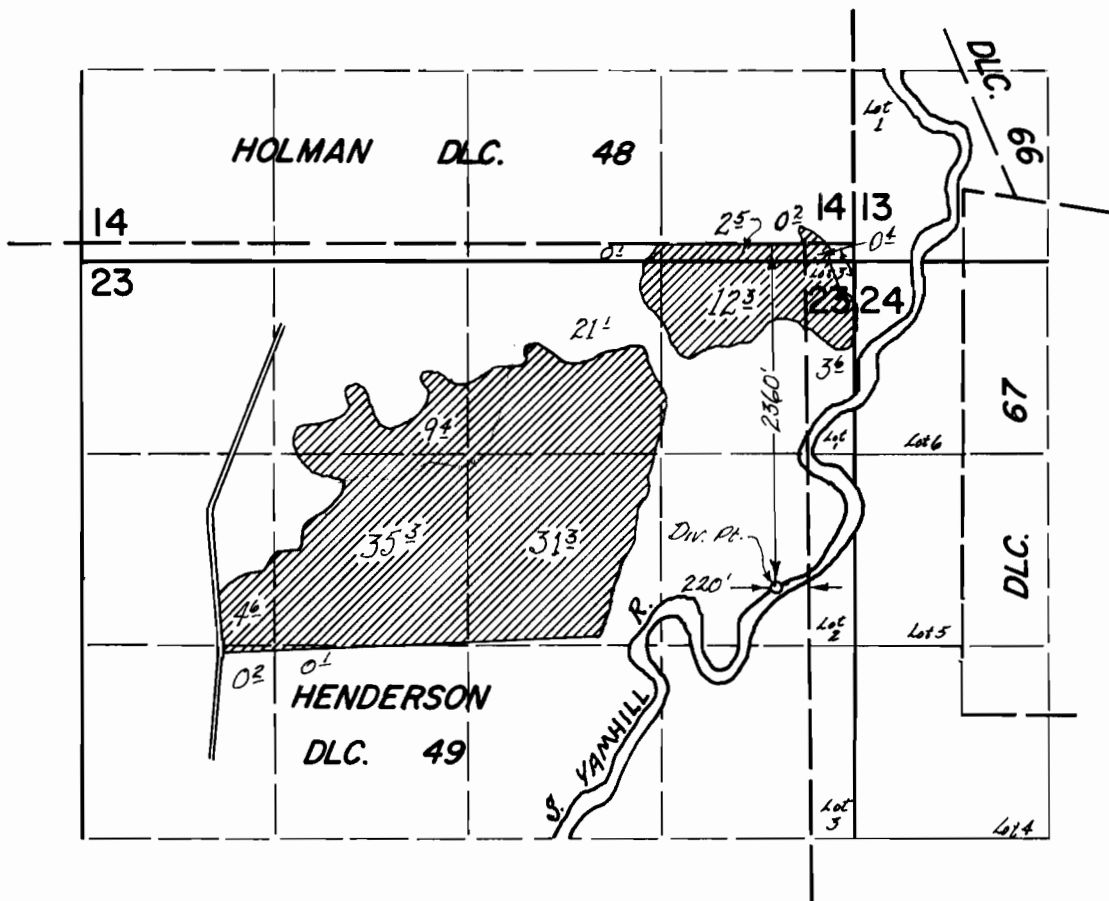

FINAL PROOF SURVEY
UNDER

Application No. 43284 Permit No. 32349
IN NAME OF

WILLIAM. A. JONES

Surveyed 27 July 1972 by D. NORBY