


T.5S., R.4W., W.M.

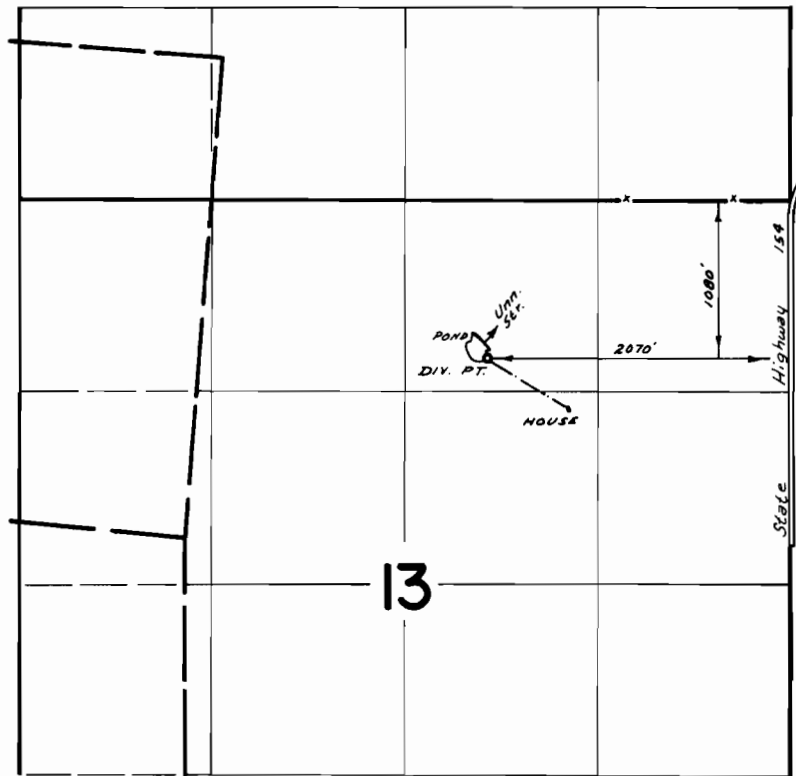

FINAL PROOF SURVEY UNDER

Application No. 43018 Permit No. 32493
IN NAME OF

ROBERT CALLANDER

Surveyed May 17 1972, by D. Norby