


T.5S., R.3W., W.M.

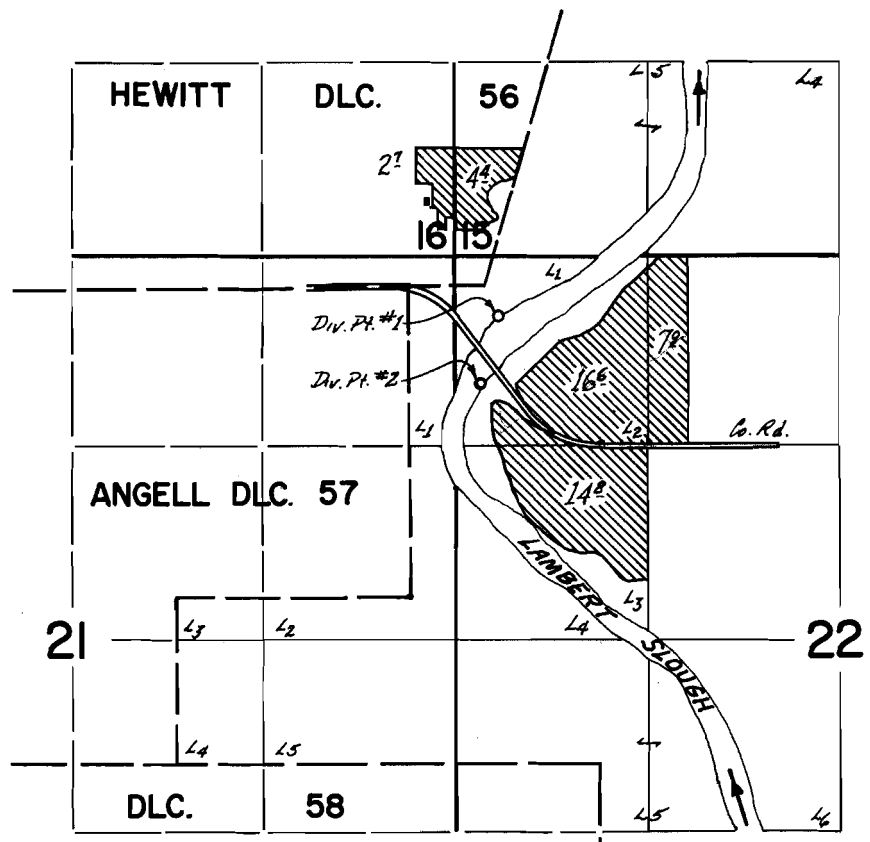

Div. Pts. located: #1 - 190' S. of 600' E.; #2 - 670' S. of 480' E.
from the NE corner Angell DLC. 57.

FINAL PROOF SURVEY
UNDER

Application No. 43588 Permit No. 32593
IN NAME OF

ARNOLD HILDEBRANDT & H. B. or LYLA M. STEINGRUBE

Surveyed 8 Nov. 1972, by D. NORBY